


3-3)

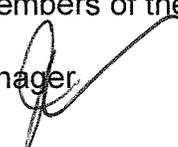

City Council Agenda Item
Meeting of January 19, 2016

TO: The Honorable Mayor and Members of the City Council
FROM: James R. O'Connor, City Manager 
DATE: January 12, 2016

SUBJECT: Indian River Farms Water Control District Permits and Interlocal Agreements (VB-2 through VB-9)

REQUESTED BY: City Manager/Indian River Farms Water Control District

The following is requested as it relates to the above-referenced agenda item:

 X Request Council review and approval based on the attached document-
ation.

 No action required. (Information only)

INDIAN RIVER FARMS WATER CONTROL DISTRICT


7305 4th Street
VERO BEACH, FLORIDA 32968
Phone: (772) 562-2141
Fax: (772) 562-2532

DAVID E. GUNTER
Secretary-Treasurer

December 18, 2015

Board of Supervisors
WILLIAM H. BARKER
BOBBY LINDSEY
MARK TRIPSON

City of Vero Beach
City Manager/Utility Director
P.O. Box 1389
Vero Beach, FL. 32961

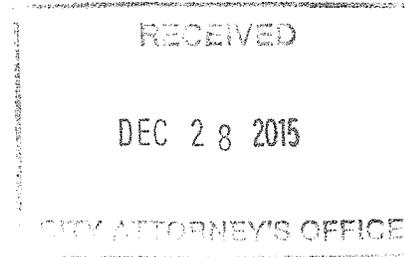

Re: Leases for utilities on District right-of-way

Dear Sir:

Enclosed please find two copies of the Interlocal Agreements between the City of Vero Beach and the Indian River Farms Water Control District for the 2016 calendar year. Kindly execute all copies of the leases and remit a check for \$22,983.07 made payable to Indian River Farms Water Control District. Upon receipt of payment and the signed agreements, the district will sign and return one copy for your records. The breakdown for the amount due is as follows:

| | |
|------|-----------------|
| VB-2 | \$12,015.00 |
| VB-3 | 195.00 |
| VB-4 | 642.00 |
| VB-5 | 1,950.00 |
| VB-6 | 5,280.00 |
| VB-7 | 745.68 |
| VB-8 | 486.50 |
| VB-9 | <u>1,668.89</u> |
| | \$22,983.07 |

Please return signed copies for our files. Please remit payment in full payable to Indian River Farms Water Control District as soon as possible.

Thank you for your anticipated cooperation in this matter.

Sincerely,

Deborah Vaughn
Administrative Assistant

PERMITS & INTERLOCAL AGREEMENTS

| <u>PERMIT NO.</u> | <u>PERMITTEE</u> | <u>DESCRIPTION</u> | <u>FEE</u> |
|-------------------|--------------------|---|-----------------|
| VB-2 | City of Vero Beach | Elect. Transmission Lines along South Relief Canal & Lat. "B" (8.01 lin. mi.) | 12,015.00 |
| VB-3 | City of Vero Beach | Reverse osmosis concentrate disposal water main along Main Canal | 195.00 |
| VB-4 | City of Vero Beach | 14" Sanitary Sewer Force Main on S 10' of Main Canal crossing at Country Club Dr. bridge | 642.00 |
| VB-5 | City of Vero Beach | Electrical Transmission Lines along No. Side of Main Canal(1.3 lin. mi.) | 1,950.00 |
| VB-6 | City of Vero Beach | 138 kv transmission line along Lat. J Canal r/w (3.52 lineal miles) | 5,280.00 |
| VB-7 | City of Vero Beach | 24" reuse line Main Canal at Country Club Dr. to I.R. Blvd. (2,316 lineal feet) | 745.68 |
| VB-8 | City of Vero Beach | 14" sanitary sewer force Main Canal at Country Club Drive (1,511 lineal feet) | 486.50 |
| VB-9 | City of Vero Beach | 24" sanitary line Main Canal At 13 th Ave to I.R. Blvd. (5,183.38 lineal feet) | <u>1,668.89</u> |
| | | Total: | \$22,983.07 |

PERMIT AND INTERLOCAL AGREEMENT

(No. VB-2)

THIS PERMIT and INTERLOCAL AGREEMENT, dated this 1st day of January, 2016, by and between **INDIAN RIVER FARMS WATER CONTROL DISTRICT**, a drainage district organized and existing under the General Drainage Laws of the State of Florida, whose address is 7305 4th Street, Vero Beach, Florida, hereinafter referred to as the "District", and the **CITY OF VERO BEACH**, a municipal corporation of the State of Florida, hereinafter referred to as the "Permittee".

NOW, THEREFORE, the District does hereby grant unto the Permittee a permit for a period of one year from January 1, 2016, unless sooner terminated as hereinafter provided, to maintain, inspect, operate and repair electrical facilities on, over and across District right-of-way along the South Relief Canal and Lateral B at the locations and in accordance with the plans and specification attached hereto and marked "Exhibit A" and signed by the parties and, by reference, made a part hereof, together with the right of ingress and egress on and over the property at said locations; provided, however, that as a condition precedent to the rights herein granted, Permittee agrees to and with the District as follows:

1. That the construction and installation of electrical facilities has been in exact conformity with the plans marked "Exhibit A".

2. That the rights herein granted shall extend to a width of twelve (12) feet at the location in accordance with and said "Exhibit A". The rights shall extend only for electrical facilities used exclusively by the City of Vero Beach (unless otherwise agreed to by District) and belonging to the Permittee and the Permittee shall not have any right to assign or sublet this Permit or any part thereof unto a third party.

3. Permittee assumes full responsibility for the operation and maintenance of said electrical facilities and shall save and hold harmless District from any expense, loss, damage or claim in regard thereto, and the District assumes and shall have no liability in connection therewith.

4. That this Permit is subject always to the paramount right of the District to keep and maintain its drainage district functions and operations, and is subject to revocation and cancellation upon thirty days' notice from District to the City and Permittee.

5. In no event shall the District be liable for any damages done or caused by the District to the public, to Permittee or any other person, using right-of-way or property subject to this Permit, and Permittee shall save the District, its officers, agents, supervisors, and employees harmless from any costs, charge or expense or claim or demand of any person against the District, to the extent permitted by law and subject to the limits provided by Section 768.28, Florida Statutes, arising from or pertaining to any use by Permittee made of the property or structures subject to the Permit. Permittee shall, as a condition to the effectiveness of this Permit, provide to District evidence satisfactory to District, of adequate commercial general liability insurance providing all risks coverage which protects Permittee and the District, its officers, agents, supervisors, and

employees from any and all claims and liabilities for bodily injury and property damage arising from Permittee operations of its use of the District right-of-way or property subject to this Permit. Coverage shall be provided in a form no more restrictive than the latest edition of the commercial general liability policy filed by the Insurance Services Office. Policies shall be endorsed to name District as an additional insured and shall include provisions for at least thirty (30) days advance notice to District by the insurer prior to any policy change, amendment, termination, or expiration of coverage. Permittee shall direct its insurance agent to provide District with a policy, an additional insured endorsement containing language no less restrictive than ISO Form CG 20 10 07 04 or ISO Form CG 20 33 07 04, and a certificate of insurance. This Permit shall be null and void if adequate insurance is not maintained by the Permittee.

6. The District may, on thirty days' written notice to the Permittee, require cessation of use within District's right-of-way, together with removal or alteration of any installation or construction on District right-of-way.

7. Any construction on District right-of-way or property and cleanup shall be completed promptly by Permittee and in a workmanlike manner with minimum disturbance to existing berm, channel slopes and grade with proper restoration and planting of any disturbed areas to prevent erosion within ten days after completion of construction or installation.

8. The Permittee shall at all times maintain cable markers above ground at 100 foot intervals to show the location of the electrical transmission cables. The electrical facilities shall be so constructed and installed to permit the crossing of heavy equipment used by the District for the maintenance of its laterals, sublaterals and canals and for any similar heavy equipment used by landowners within the District. In any case where the electrical transmission line crosses a piper or culvert used for drainage or irrigation purposes, or a pipe or culvert is needed hereafter for drainage or irrigation of adjacent lands, and the same is deemed by District or an adjacent landowner to be required to be installed, repaired or replaced, then, upon twenty-four (24) hours' notice, Permittee shall, at Permittee's sole cost and expense, be available at the location of, and arrange for such installation, repair or replacement with personnel and equipment to insure that the electrical transmission line does not endanger or prevent the installation, repair, replacement or use of pipes or culverts for drainage or irrigation purposes. The District has the right to determine the exact location of each electrical transmission line within the said right-of-way in order that the location of same shall not interfere with the District's functions and operations and of the District land owners.

9. Permittee shall advise District's office prior to commencement or completion of all construction.

10. Permittee shall not discharge any pollutants, contaminants or deleterious materials into waters or structures owned or maintained by, or subject to the jurisdiction of District, not permit anything to obstruct the flow of water, and shall save and hold District harmless from any expense, loss or damage to District or others by any such

discharge or obstruction, remedying or removing the same immediately upon request by District.

11. This Permit shall exist only so long as Permittee may be in full compliance with all requirements of the Department of Environmental Protection for the State of Florida, as such requirements relate to this project, and if, at any time, the Contracting Permittee shall fail to meet such requirements, then this Permit shall, ipso facto, immediately become null and void.

12. Permittee, as a condition to the continuance of this Permit, shall reimburse District, immediately on demand, for any fees for testing or other professional services, costs or expenses to District associated with or arising from Permittee's use of District right-of-way.

13. The Permittee shall pay to the District an annual rental of Twelve Thousand Fifteen and No/100 Dollars (\$12,015.00) which is computed as follows: 8.01 lineal miles of right-of-way subject to this Permit at Fifteen Hundred Dollars (\$1,500.00) per lineal mile, payable in advance. In addition to the permit fee payable hereunder, if the permit applied for or the use for which the permit is granted requires engineering or legal work for purpose of processing and approval by District, then Permittee shall pay promptly when invoiced all engineering and legal fees incurred by District in connection herewith and shall indemnify District for the same, saving and holding District harmless from any liability in connection therewith.

14. This Permit shall be effective January 1, 2015, and continue for a period of one year unless sooner terminated as provided herein.

15. In the event that this Permit is canceled or terminated, the Permittee shall, at its expense, promptly remove all electrical facilities from the right-of-way of the District.

16. This Permit shall be considered to be a license only, for the limited purpose of installation, placement and maintenance of the improvements specified on the face hereof, and does not convey any other right, title or interest of the District in the subject right-of-way property.

17. In the event of any dispute arising hereunder, the parties agree that, as a condition precedent to litigation, the parties shall first submit the same to non-binding mediation with a Florida Circuit Court certified civil mediator with the cost of such mediation shared equally between the parties.

18. Permittee assumes full responsibility for any construction, operation or maintenance on District property or right-of-way subject to this Permit and understands and agrees that Permittee's use of District property for Permittee's purposes and benefit is at Permittee's sole risk; any loss or damage to Permittee's property, installations, facilities or personnel while on District property or right-of-way, regardless of the cause of the same, including, without limitation, negligence or want or care on the part of District, its agents or employees, whether by reason of the provisions of Chapter 556, Florida Statutes, or otherwise, is Permittee's and not District's (except as may be otherwise provided by Section 768.28, Florida Statutes) and, as a condition of this Permit,

Permittee promises, covenants and agrees that neither Permittee, nor anyone claiming by, through or under Permittee, shall have any claim or cause of action against District by reason of such loss or damage. The parties hereto further acknowledge and agree that District has no obligation to allow Permittee to enter upon or use District's property or right-of-way, and does so only in consideration of Permittee's release of District from any responsibility or liability whatsoever, including for damage caused by District's negligence, now or in the future, and Permittee agrees that it is able, at its own expense, to insure against loss or damage, without granting any right of subrogation to claims against District or Permittee.

19. This Permit may not be assigned or subletted to a third party and any transfer of Permittee's property abutting District's property or right-of-way shall, ipso facto and without more, cancel, nullify and revoke this Permit.

20. Permittee understands, acknowledges and agrees that the business of District is digging within the area of its rights of way and sole responsibility for damage to any facilities, structures or property located underground is Permittee's and not the District's.

21. In consideration of the grant of this Permit, Permittee, if a public or private body with the power of eminent domain, expressly waives and relinquishes any power of eminent domain or condemnation of the property as to which this Permit applies for the use for which the Permit is granted. This clause shall survive termination or expiration of this Permit.

IN WITNESS WHEREOF, said District has caused these present to be executed in its name by its Secretary and its corporate seal hereto affixed, by due authority of its Board of Supervisors, this ____ day of _____, 2016.

Signed, seal and delivered
in the presence of:

as to District

**INDIAN RIVER FARMS WATER
CONTROL DISTRICT**

By: _____
David E. Gunter, Secretary

(SEAL)

Permittee hereby accepts the terms of this Permit, and covenants and agree that it will comply with the terms and conditions of this Permit.


Dated this ____ day of _____, 2016.

Signed, sealed and delivered
in the presence of:

CITY OF VERO BEACH

By: _____
Mayor

Attest: _____
City Clerk
(SEAL)

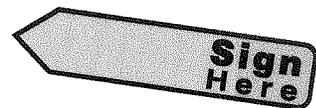

| CITY OF VERO BEACH | APPROVED | DATE |
|--------------------|----------|---------|
| City Manager | | |
| City Attorney | WRC | 11/8/16 |
| City Clerk | | |
| Utilities - ELC | JF | 1-12-16 |
| Public Works | | |
| Finance | | |
| Human Resources | | |
| Planning | | |
| | | |




North

VB-2, VB-5, VB-6
INDIAN RIVER FARMS PERMITS
CITY OF VERO BEACH
TRANSMISSION LINES ON
INDIAN RIVER FARMS RIGHT-OF-WAY

DWG: DVA APP: JD/LTR

DATE: 09/26/01

ATTACHMENT PROVIDED BY COVB
FOR MUNICIPAL PURPOSES
MARCH 2011

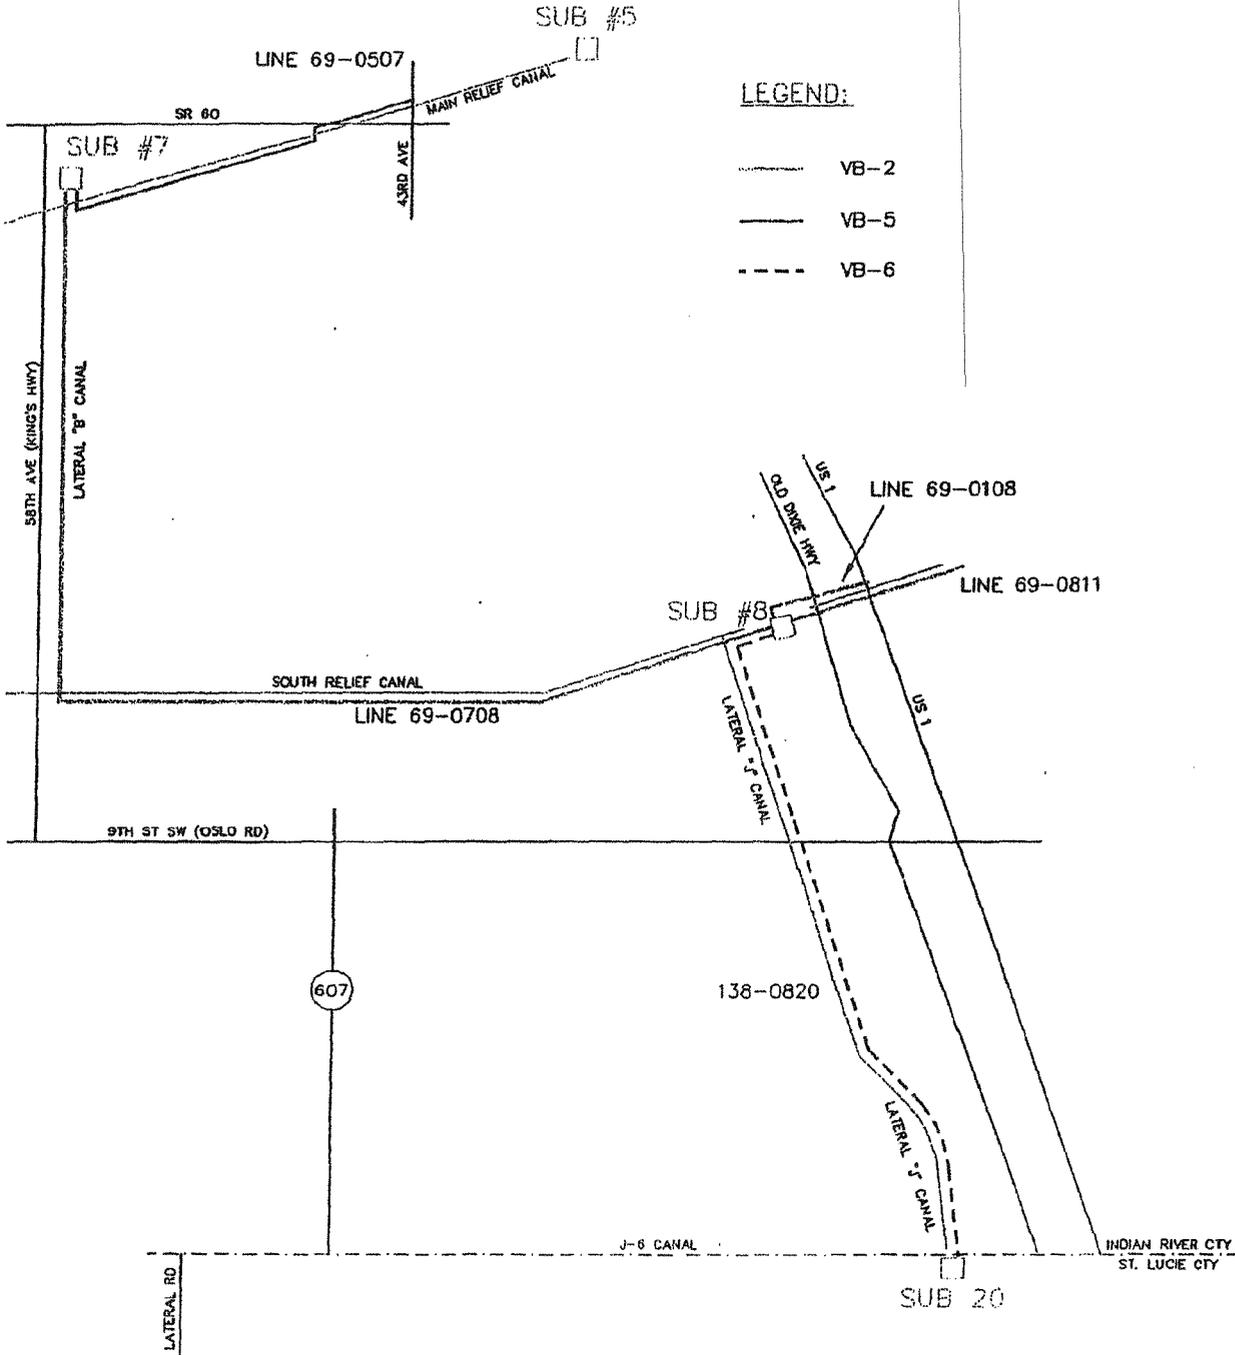

LEGEND:

- VB-2
- - - VB-5
- - - VB-6

PERMIT AND INTERLOCAL AGREEMENT

(No. VB-3)

THIS PERMIT and INTERLOCAL AGREEMENT, dated this 15th day of JANUARY, 2016, by and between **INDIAN RIVER FARMS WATER CONTROL DISTRICT**, a drainage district organized and existing under the General Drainage Laws of the State of Florida, whose address is 7305 4th Street, Vero Beach, Florida, hereinafter referred to as the "District", and the **CITY OF VERO BEACH**, a municipal corporation of the State of Florida, hereinafter referred to as the "Permittee".

NOW, THEREFORE, the District does hereby grant unto the Permittee a permit for a period of commencing from January 1, 2016 and continuing until December 31, 2016, unless sooner terminated as hereinafter provided, to maintain, inspect, operate and repair reverse osmosis concentrate disposal water main and appurtenances on, over and across District right-of-way along the Main Canal, together and with the right of ingress and egress on and over the property at said locations; provided, however, that as a condition precedent to the rights herein granted, Permittee agrees to and with the District as follows:

1. That the construction and installation of reverse osmosis concentrate disposal water main has been in exact conformity with the as-built plans prepared by Boyle Engineering Corporation, Job No. FM-V88-104-10.

2. That the rights herein granted shall extend to a width of ten (10) feet at the location in accordance with and said plans. The rights shall extend only for reverse osmosis concentrate disposal water mains used exclusively by the Permittee belonging to the Permittee and the Permittee shall not have any right to assign or sublet this Permit or any part thereof unto a third party.

3. Permittee assumes full responsibility for the operation and maintenance of said reverse osmosis concentrate disposal water main and shall save and hold harmless District from any expense, loss, damage or claim in regard thereto, and the District assumes and shall have no liability in connection therewith.

4. That this Permit is subject always to the paramount right of the District to keep and maintain its drainage district functions and operations, and is subject to revocation and cancellation upon thirty days' notice from District to the City and Permittee.

5. In no event shall the District be liable for any damages done or caused by the District to the public, to Permittee or any other person, using right-of-way or property subject to this Permit, and Permittee shall save the District, its officers, agents, supervisors, and employees harmless from any costs, charge or expense or claim or demand of any person against the District, to the extent permitted by law and subject to the limits provided by Section 768.28, Florida Statutes, arising from or pertaining to any use by Permittee made of the property or structures subject to the Permit. Permittee shall, as a condition to the effectiveness of this Permit, provide to District evidence satisfactory to District, of adequate commercial general liability insurance providing all risks coverage which protects Permittee and the District, its officers, agents, supervisors, and employees for any and all claims and liabilities for bodily injury and property damage arising from Permittee operations of its use of the District right-of-way or property subject to this Permit. Coverage shall be provided in a form no more restrictive than the latest edition of the commercial general liability policy filed by the Insurance Services office. Policies shall be endorsed to name District as an additional insured and shall include

provision for at least thirty (30) days advance notice to District by the insurer prior to any policy change, amendment, termination, or expiration of coverage. Permittee shall direct its insurance agent to provide District with a policy, an additional insured endorsement containing language no less restrictive than ISO Form CG 20 10 07 04 or ISO Form CG 20 33 07 04, and a certificate of insurance. This Permit shall be null and void if adequate insurance is not maintained by the Permittee.

6. The District may, on thirty days' written notice to the Permittee, require cessation of use into District's facilities, removal or alteration of any installation or construction on District right-of-way.

7. Any construction on District right-of-way or property and cleanup shall be completed promptly by Permittee and in a workmanlike manner with minimum disturbance to existing berm, channel slopes and grade with proper restoration and planting of any disturbed areas to prevent erosion within ten days after completion of construction or installation.

8. The Permittee shall at all times maintain cable markers above ground at 100 foot intervals to show the location of the electrical transmission cables. The mains shall be constructed and installed so that there is a minimum depth of at least thirty-six (36) inches from the ground to the top of said mains and to permit the crossing of heavy equipment used by the District for the maintenance of its laterals, sublaterals and canals and for any similar heavy equipment used by land owners within the District. In any case where the reverse osmosis concentrate disposal water main crosses a pipe or culvert used for drainage or irrigation purposes, or a pipe or culvert is needed hereafter for drainage or irrigation of adjacent lands, and the same is deemed by District or an adjacent landowner to be required to be installed, repaired or replaced, then, upon twenty-four (24) hours' notice, Permittee shall, at Permittee's sole cost and expense, be available at the location of, and arrange for such installation, repair or replacement with personnel and equipment to insure that the electrical transmission line does not endanger or prevent the installation, repair, replacement or use of pipes or culverts for drainage or irrigation purposes. The District has the right to determine the exact location of the reverse osmosis concentrate disposal water main within the said right-of-way in order that the location of same shall not interfere with the District's function and operations and of the District land owners.

9. Permittee shall advise District's office prior to commencement or completion of all construction.

10. Permittee shall not discharge any pollutants, contaminants or deleterious materials into waters or structures owned or maintained by, or subject to the jurisdiction of District, nor permit anything to obstruct the flow of water, and shall save and hold District harmless from any expense, loss or damage to District or others by any such discharge or obstruction, remedying or removing the same immediately upon request by District.

11. This Permit shall exist only so long as Permittee may be in full compliance with all requirements of the Department of Environmental Protection for the State of Florida, as such requirements relate to this project, and if, at any time, the Contracting Permittee shall fail to meet such requirements, then this Permit, ipsofacto, immediately become null and void.

12. This Permit shall be subject to approval by, and appropriate permits from, all local, state and federal agencies having jurisdiction in this project.

13. The quantity and quality of the water discharged through this reverse osmosis concentrate disposal water main shall be in conformity with any and all federal, state and local requirements. All discharge through this reverse osmosis concentrate disposal water main shall be subject to water quality testing procedures in conformance with District, federal, state or local requirements, said testing to be performed at regular intervals by a qualified and approved testing company at no cost to the District.

14. Permittee, as a condition to the continuance of this Permit, shall reimburse District, immediately on demand, for any fees for testing or other professional services, costs or expenses to District associated with or arising from Permittee's use of District right-of-way.

15. The Permittee shall pay to the District an annual rental of One Hundred Ninety Five and No/100 Dollars (\$195.00), payable annually in advance. In addition to the permit fee payable hereunder, if the permit applied for or the use for which the permit is granted requires engineering or legal work for purposes of processing and approval by District, then Permittee shall pay promptly when invoiced all engineering and legal fees incurred by District in connection herewith and shall indemnify District for the same, saving and holding District harmless from any liability in connection therewith.

16. This Permit shall be effective January 1, 2016 and continue until December 31, 2016, unless sooner terminated as provided herein.

17. In the event that this Permit is canceled or terminated, the Permittee shall, at its expense, promptly removal all mains from the right-of-way of the District.

18. This Permit shall be considered to be a license only, for the limited purpose of installation, placement and maintenance of the improvements specified on the face hereof, and does not convey any other right, title or interest of the District in the subject right-of-way property.

19. In the event of any dispute arising hereunder, the parties agree that, as a condition precedent to litigation, the parties shall first submit the same to non-binding arbitration for resolution.

20. Permittee assumes full responsibility for any construction, operation or maintenance on District property or right-of-way subject to the Permit and understands and agrees that Permittee's use of District property for Permittee's purposes and benefit is at Permittee's sole risk; any loss or damage to Permittee's property, installations, facilities or personnel while on District property or right-of-way, regardless of the cause of the same, including, without limitation, negligence or want or care on the part of District, its agents or employees, whether by reason of the provisions of Chapter 556, Florida Statutes, or otherwise, is Permittee's and not District's (except as may be otherwise provided by Section 768.28, Florida Statutes) and, as a condition of this Permit, Permittee promises, covenants and agrees that neither Permittee, nor anyone claiming by, through or under Permittee, shall have any claim or cause of action against District by reason of such loss or damage. The parties hereto further acknowledge and agree that District has no obligation to allow Permittee to enter upon or use District's property or right-of-way, and does so only in consideration of Permittee's release of District from any responsibility or liability whatsoever, including for damage cause by District's negligence, now or in the future, and Permittee agrees that it is able, at its own expense, to insure against loss or damage, without granting any right of subrogation to claims against District or Permittee.

21. This Permit may not be assigned or subletted to a third party and any transfer of Permittee's property abutting District's property or right-of-way shall, ipsofacto and without more, cancel, nullify and revoke this Permit.

22. Permittee understands, acknowledges and agrees that the business of the District is digging within the area of its rights of way and sole responsibility for damage to any facilities, structures or property located underground is Permittee's and not the District's.

23. In consideration of the grant of this Permit, Permittee, if a public or private body with the power of eminent domain, expressly waives and relinquishes any power of eminent domain or condemnation of the property as to which this Permit applies for the use for which the Permit is granted. His clause shall survive termination or expiration of this Permit.

IN WITNESS WHEREOF, said District has caused these present to be executed in its name by its Secretary and its corporate seal hereto affixed, by due authority of its Board of Supervisors, this ____ day of _____, 2016.

Signed, sealed and delivered
in the presence of:

as to District

**INDIAN RIVER FARMS WATER
CONTROL DISTRICT**

By: _____
David E. Gunter, Secretary

(SEAL)

Permittee hereby accepts the terms of this Permit, and covenants and agree that it will comply with the terms and conditions of this Permit. Dated this ____ day of _____, 2016.

Signed, sealed and delivered
in the presence of:

as to Permittee


CITY OF VERO BEACH


By: _____
Mayor

Attest: _____
City Clerk

(SEAL)

| CITY OF VERO BEACH | APPROVED | DATE |
|--------------------|----------|---------|
| City Manager | | |
| City Attorney | WR | 1/8/16 |
| City Clerk | | |
| Utilities - WS | WS | 1/12/16 |
| Public Works | | |
| Finance | | |
| Human Resources | | |
| Planning | | |
| | | |

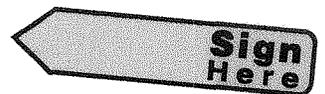

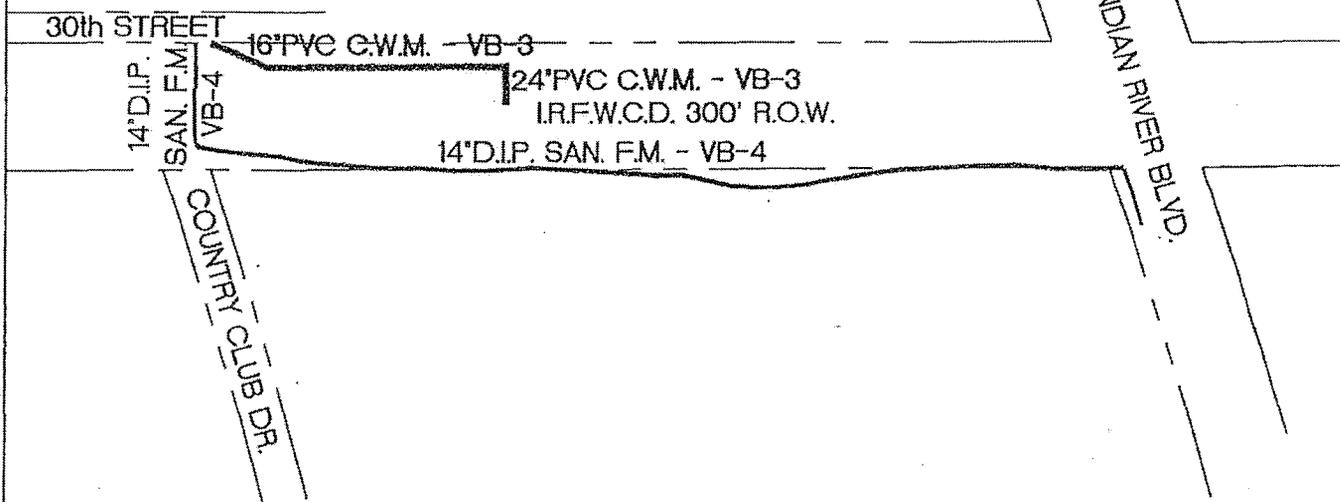

ATTACHMENT PROVIDED BY COVB
 FOR MUNICIPAL PURPOSES
 MARCH 2011

| | | | |
|--|---|------------------|---------------------|
| CITY OF VERO BEACH WATER AND SEWER DEPARTMENT ENGINEERING DIVISION | EXHIBIT for INDIAN RIVER FARMS WATER CONTROL DISTRICT PERMITS VB-3 and VB-4 | DATE 3/2/2011 | DRAWN BY: T.A.Y. |
| | | APPR. R.J.B. | DWG. NO. EX. 1 |
| | | REV. | PAGE 1 OF 1 |

PERMIT AND INTERLOCAL AGREEMENT

(No. VB-4)

THIS PERMIT and INTERLOCAL AGREEMENT, dated this 1st day of JANUARY, 2016, by and between **INDIAN RIVER FARMS WATER CONTROL DISTRICT**, a drainage district organized and existing under the General Drainage Laws of the State of Florida, whose address is 7305 4th Street, Vero Beach, Florida, hereinafter referred to as the "District", and the **CITY OF VERO BEACH**, a municipal corporation of the State of Florida, hereinafter referred to as the "Permittee".

NOW, THEREFORE, the District does hereby grant unto the Permittee a permit for a period of one year from January 1, 2016, unless sooner terminated as hereinafter provided, to maintain, inspect, operate and repair a 14" diameter sanitary sewer force main on, over and across District right-of-way of the Main Canal at Country Club Drive Bridge, for a distance of approximately 2,260 lineal feet at the locations and in accordance with the plans and specifications attached hereto and marked "Exhibit A" and signed by the parties and, by reference, made a part hereof, together with the right of ingress and egress on and over the property at said locations; provided, however, that as a condition precedent to the right herein granted, Permittee agrees to and with the District as follows:

1. That the construction and installation of force main has been in exact conformity with the as-built plans prepared by Kimball/Lloyd & Associates, Inc., Job No. 87-475, dated 4/90.

2. That the rights shall extend only for force main used exclusively by the City of Vero Beach (unless otherwise agreed to by District) and belonging to the Permittee and the Permittee shall not have any right to assign or sublet this Permit or any part thereof unto a third part.

3. Permittee assumes full responsibility for the operation and maintenance of said force main and shall save and hold harmless District from any expense, loss, damage or claim in regard thereto, and the District assumes and shall have no liability in connection therewith.

4. That this Permit is subject always to the paramount right of the District to keep and maintain its drainage district functions and operations, and is subject to revocation and cancellation upon thirty days' notice from District to the City and Permittee.

5. In no event shall the District be liable for any damages done or caused by the District to the public, to Permittee or any other person, using right-of-way or property subject to this Permit, and Permittee shall save the District, its officers, agents, supervisors, and employees harmless from any costs, charge or expense or claim or demand of any person against the District, to the extent permitted by law and subject to the limits provided by Section 768.28, Florida Statutes, arising from or pertaining to any use by Permittee made of the property or structures subject to the Permit. Permittee shall, as a condition to the effectiveness of this Permit, provide to District evidence satisfactory to District, of adequate commercial general liability insurance providing all risks coverage which protects Permittee and the District, its officers, agents, supervisors, and employees for any and all claims and liabilities for bodily injury and property

damage arising from Permittee operations of its use of the District right-of-way or property subject to this Permit. Coverage shall be provided in a form no more restrictive than the latest edition of the commercial general liability policy filed by the Insurance Services office. Policies shall be endorsed to name District as an additional insured and shall include provision for at least thirty (30) days advance notice to District by the insurer prior to any policy change, amendment, termination, or expiration of coverage. Permittee shall direct its insurance agent to provide District with a policy, an additional insured endorsement containing language no less restrictive than ISO Form CG 20 10 07 04 or ISO Form CG 20 33 07 04, and a certificate of insurance. This Permit shall be null and void if adequate insurance is not maintained by the Permittee.

6. The District may, on thirty days' written notice to the Permittee, require cessation of use into District's facilities, removal or alteration of any installation or construction on District right-of-way.

7. The Permittee shall at all times maintain cable markers above ground at 100 foot intervals to show the location of any underground objects. The force main shall be constructed and installed to permit the crossing of heavy equipment used by the District for the maintenance of its laterals, sub-laterals and canals and for any similar heavy equipment used by land owners within the District. In any case where the force main crosses a pipe or culvert used for drainage or irrigation purposes, or a pipe or culvert is needed hereafter for drainage or irrigation of adjacent lands, and the same is deemed by District or an adjacent landowner to be required to be installed, repaired or replaced, then upon twenty-four (24) hours notice, Permittee shall, at Permittee's sole cost and expense, be available at the location of, and arrange for such installation, repair or replacement with personnel and equipment to insure that the force main does not endanger or prevent the installation, repair, replacement or use of pipes or culverts for drainage or irrigation purposes. The District has the right to determine the exact location of the force main within the said right-of-way in order that the location of name shall not interfere with the District's functions and operations and of the District land owners.

8. Permittee shall advise District's office prior to commencement or completion of all construction.

9. Permittee shall not discharge any pollutants, contaminants or deleterious materials into waters or structures owned or maintained by, or subject to the jurisdiction of District, nor permit anything to obstruct the flow of water, and shall save and hold District harmless from an expense, loss or damage to District or others by any such discharge or obstruction, remedying or removing the same immediately upon request by District.

10. This Permit shall exist only so long as Permittee may be in full compliance with all requirements of the Department of Environmental Protection for the State of Florida, as such requirements relate to this project, and if, at any time, the Permittee shall fail to meet such requirements, then this Permit shall, ipso facto, immediately become null and void.

11. Permittee, as a condition to the continuance of this Permit, shall reimburse District, immediately on demand, for any fees for testing or other professional services,

costs or expenses to District associated with or arising from Permittee's use of District right-of-way.

12. The Permittee shall pay to the District an annual rent of Six Hundred Forty Two and 00/100 Dollars (\$642.00), payable in advance. In addition to the permit fee payable hereunder, if the permit applied for or the use for which the permit is granted requires engineering or legal work for purposes of processing and approval by District, then Permittee shall pay promptly when invoiced all engineering and legal fees incurred by District in connection herewith and shall indemnify District for the same, saving and holding District harmless from any liability in connection therewith.

13. This Permit shall be effective January 1, 2016, and continue for a period of one year unless sooner terminated as provided herein.

14. In the event that this Permit is canceled or terminated, the Permittee shall, at its expense, promptly remove the sewer force main from the right-of-way of the District.

15. This Permit shall be considered to be a license only, for the limited purpose of installation, placement and maintenance of the improvements specified on the face hereof, and does not convey any other right, title or interest of the District in the subject right-of-way property.

16. In the event of any dispute arising hereunder, the parties agree that, as a condition precedent to litigation, the parties shall first submit the same to non-binding arbitration for resolution.

17. Permittee assumes full responsibility for any construction, operation or maintenance on District property or right-of-way subject to the Permit and understands and agrees that Permittee's use of District property for Permittee's purposes and benefit is at Permittee's sole risk; any loss or damage to Permittee's property, installations, facilities or personnel while on District property or right-of-way, regardless of the cause of the same, including, without limitation, negligence or want or care on the part of District, its agents or employees, whether by reason of the provision of Chapter 556, Florida Statutes, or otherwise, is Permittee's and not District's (except as may be otherwise provided by Section 768.28, Florida Statutes) and, as a condition of this Permit, Permittee promises, covenants and agrees that neither Permittee, nor anyone claiming by, through or under Permittee, shall have any claim or cause of action against District by reason of such loss or damage. The parties hereto further acknowledge and agree that District has no obligation to allow Permittee to enter upon or use District's property or right-of-way, and does so only in consideration of Permittee's release of District from any responsibility or liability whatsoever, including for damage caused by District's negligence, now or in the future, and Permittee agrees that it is able, at its own expense, to insure against loss or damage, without granting any right of subrogation to claims against District or Permittee.

18. This Permit may not be assigned or sublet to a third party and any transfer of Permittee's property abutting District's property or right-of-way shall, ipso facto and without more, cancel, nullify and revoke this Permit.

19. Permittee understands, acknowledges and agrees that the business of the District is digging within the area of its rights of way and sole responsibility for damage to any facilities, structures or property located underground is Permittee's and not the District's.

20. In consideration of the grant of this Permit, Permittee, if a public or private body with the power of eminent domain, expressly waives and relinquishes power of eminent domain or condemnation of the property as to which this Permit applies for the use for which the Permit is granted. This clause shall survive termination or expiration of this Permit.

IN WITNESS WHEREOF, said District has caused these present to be executed in its name by its Secretary and its corporate seal hereto affixed, by due authority of its Board of Supervisors, this ____ day of _____, 2016.

Signed, sealed and delivered
in the presence of:

as to District

(SEAL)

INDIAN RIVER FARMS WATER CONTROL DISTRICT

By: _____
David E. Gunter, Secretary

Permittee hereby accepts the terms of this Permit, and covenants and agrees that it will comply with the terms and condition of this Permit.

Dated this ____ day of _____, 2016.

Signed, sealed and delivered
in the presence of:

as to Permittee


CITY OF VERO BEACH


By: _____
Mayor

Attest: _____
City Clerk

(SEAL)

| CITY OF VERO BEACH | APPROVED | DATE |
|-----------------------|------------|-----------------|
| City Manager | | |
| City Attorney | <i>WCC</i> | <i>11/21/16</i> |
| City Clerk | | |
| Utilities - <i>WS</i> | <i>Ryb</i> | <i>1/12/16</i> |
| Public Works | | |
| Finance | | |
| Human Resources | | |
| Planning | | |
| | | |
| | | |

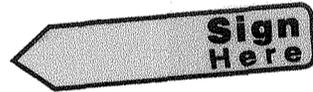

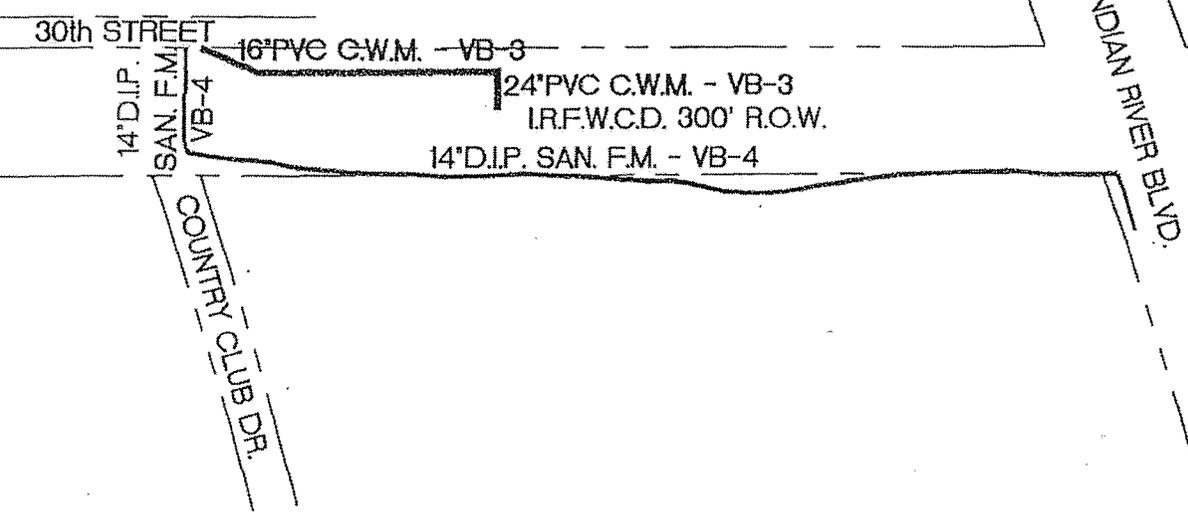

ATTACHMENT PROVIDED BY COVB
FOR MUNICIPAL PURPOSES
MARCH 2011

| | | | |
|--|---|------------------|---------------------|
| CITY OF VERO BEACH WATER AND SEWER DEPARTMENT ENGINEERING DIVISION | EXHIBIT for INDIAN RIVER FARMS WATER CONTROL DISTRICT PERMITS VB-3 and VB-4 | DATE 3/2/2011 | DRAWN BY: T.A.Y. |
| | | APPR. R.J.B. | DWG. NO. EX. 1 |
| | | REV. | PAGE 1 OF 1 |

PERMIT AND INTERLOCAL AGREEMENT

(No. VB-5)

THIS PERMIT and INTERLOCAL AGREEMENT, dated this 1ST day of JANUARY, 2016, by and between **INDIAN RIVER FARMS WATER CONTROL DISTRICT**, a drainage district organized and existing under the General Drainage Laws of the State of Florida, whose address is 7305 4th Street, Vero Beach, Florida, hereinafter referred to as the "District", and the **CITY OF VERO BEACH**, a municipal corporation of the State of Florida, hereinafter referred to as the "Permittee".

NOW, THEREFORE, the District does hereby grant unto the Permittee a permit for a period of one year from January 1, 2016, unless sooner terminated as hereinafter provided, to maintain, inspect, operate and repair electrical transmission lines and utility poles on, over and across District right-of-way along the Main Canal at the locations and in accordance with the plans and specifications attached hereto and marked "Exhibit A" and signed by the parties and, by reference, made a part hereof, together with the right of ingress and egress on and over the property at said locations; provided, however, that as a condition precedent to the right herein granted, Permittee agrees to and with the District as follows:

1. That the rights herein granted shall extend into District right-of-way from utility pole to utility pole in the locations and widths, which vary from utility pole to utility pole, as shown on the plans approved by the District in accordance with said "Exhibit A". the rights shall extend only for electrical facilities used exclusively by the City of Vero Beach (unless otherwise agreed to by District) and belonging to the Permittee and the Permittee shall not have any right to assign or sublet this Permit or any part thereof unto a third party.

2. Permittee assumes full responsibility for the operation and maintenance of said electrical facilities and shall save and hold harmless District from any expense, loss, damage or claim in regard thereto, and the District assumes and shall have no liability in connection therewith.

3. That this Permit is subject always to the paramount right of the District to keep and maintain its drainage district functions and operations, and is subject to revocation and cancellation upon thirty days' notice from District to the City and Permittee.

4. In no event shall the District be liable for any damages done or caused by the District to the public, to Permittee or any other person, using right-of-way or property subject to this Permit, and Permittee shall save the District, its officers, agents, supervisors, and employees harmless from any costs, charge or expense or claim or demand of any person against the District, to the extent permitted by law and subject to the limits provided by Section 768.28, Florida Statutes, arising from or pertaining to any use by Permittee made of the property or structures subject to the Permit. Permittee shall, as a condition to the effectiveness of this Permit, provide to District evidence satisfactory to District, of adequate commercial general liability insurance providing all risks coverage which protects Permittee and the District, its officers, agents, supervisors, and employees for any and all claims

and liabilities for bodily injury and property damage arising from Permittee operations of its use of the District right-of-way or property subject to this Permit. Coverage shall be provided in a form no more restrictive than the latest edition of the commercial general liability policy filed by the Insurance Services office. Policies shall be endorsed to name District as an additional insured and shall include provision for at least thirty (30) days advance notice to District by the insurer prior to any policy change, amendment, termination, or expiration of coverage. Permittee shall direct its insurance agent to provide District with a policy, an additional insured endorsement containing language no less restrictive than ISO Form CG 20 10 07 04 or ISO Form CG 20 33 07 04, and a certificate of insurance. This Permit shall be null and void if adequate insurance is not maintained by the Permittee.

5. Permittee is cautioned that electrical, water, sewer, gas or other installations or utilities may be located within the permit area, and Permittee shall use diligent efforts to first detect and locate all such installations and shall coordinate construction with all other lawful users of said right-of-way. Permittee shall be liable for all damages proximately resulting from its interference with or interruption of services provided by other lawful right-of-way users.

6. The District may, on thirty days' written notice to the Permittee, require cessation of use into District's facilities, removal or alteration of any installation or construction on District right-of-way.

7. Any construction on District right-of-way or property and cleanup shall be completed promptly by Permittee and in a workmanlike manner with minimum disturbance to existing berm, channel slopes and grade with proper restoration and planting of any disturbed areas to prevent erosion within ten days after completion of construction or installation.

8. The Permittee shall at all times maintain cable markers above ground at 100 foot intervals to show the location of the electrical transmission cables. The electrical transmission lines and utility pole shall be constructed and installed to permit the crossing of heavy equipment used by the District for the maintenance of its laterals, sublaterals and canals and for any similar heavy equipment used by land owners within the District. In any case where the electrical transmission line crosses a pipe or culvert used for drainage or irrigation purposes, or a pipe or culvert is needed hereafter for drainage or irrigation of adjacent lands, and the same is deemed by District or an adjacent landowner to be required to be installed, repaired or replaced, then, upon twenty-four (24) hours' notice, Permittee shall, at Permittee's sole cost and expense, be available at the location of, and arrange for such installation, repair or replacement with personnel and equipment to insure that the force main does not endanger or prevent the installation, repair, replacement or use of pipes or culverts for drainage or irrigation purposes. The District has the right to determine the exact location of each electrical transmission line within the said right-of-way in order that the location of same shall not interfere with the District's functions and operation and of the District land owners.

9. Permittee shall advise District's office prior to commencement or completion of all construction.

10. Permittee shall not discharge any pollutants, contaminants or deleterious materials into waters or structures owned or maintained by, or subject to the jurisdiction of District, no permit anything to obstruct the flow of water, and shall save and hold District harmless from an expense, loss or damage to District or others by any such discharge or obstruction, remedying or removing the same immediately upon request by District.

11. This Permit shall exist only so long as Permittee may be in full compliance with all requirements of the Department of Environmental Protection for the State of Florida, as such requirements relate to this project, and if, at any time, the Permittee shall fail to meet such requirements, then this Permit shall, ipso facto, immediately become null and void.

12. Permittee, as a condition to the continuance of this Permit, shall reimburse District, immediately on demand, for any fees for testing or other professional services, costs or expenses to District associated with or arising from Permittee's use of District right-of-way.

13. The Permittee shall pay to the District an annual rent of One Thousand Nine Hundred Fifty and No/100 Dollars (\$1,950.00), payable in advance, which is computed as follows: 1.3 lineal miles of right-of-way subject to this Permit at Fifteen Hundred Dollars (\$1,500.00) per lineal mile. In addition to the permit fee payable hereunder, if the permit applied for or the use for which the permit is granted requires engineering or legal work for purposes of processing and approval by District, then Permittee shall pay promptly when invoiced all engineering and legal fees incurred by District in connection herewith and shall indemnify District for the same, saving and holding District harmless from any liability in connection therewith.

14. This Permit shall be effective January 1, 2016, and continue for a period of one year unless sooner terminated as provided herein.

15. In the event that this Permit is canceled or terminated, the Permittee shall, at its expense, promptly remove all electrical transmission lines and utility poles from the right-of-way of the District.

16. This Permit will lapse and be of no further force or effect if, within six months from date, Permittee fails to remove or replace old culverts into the Main Canal for Permittee's airport property, removal all utility poles and place all transmission poles on the line west of the Main Canal bridge on the South side and East of bridge on the North right-of-way of the Main Canal, fence and secure District's right-of-way at each road crossing; upon lapse of this Permit, as aforesaid, Permittee shall vacate and remove all of Permittee's property and equipment from District right-of-way.

17. This Permit shall be considered to be a license only, for the limited purpose of installation, placement and maintenance of the improvements specified on the face

hereof, and does not convey any other right, title or interest of the District in the subject right-of-way property.

18. In the event of any dispute arising hereunder, the parties agree that, as a condition precedent to litigation, the parties shall first submit the same to non-binding mediation with a Florida Circuit Court certified civil mediator with the cost of such mediation shared equally between the parties.

19. Permittee assumes full responsibility for any construction, operation or maintenance on District property or right-of-way subject to the Permit and understands and agrees that Permittee's use of District property for Permittee's purposes and benefit is at Permittee's sole risk; any loss or damage to Permittee's property, installations, facilities or personnel while on District property or right-of-way, regardless of the cause of the same, including, without limitation, negligence or want or care on the part of District, its agents or employees, whether by reason of the provision of Chapter 556, Florida Statutes, or otherwise, is Permittee's and not District's (except as may be otherwise provided by Section 768.28, Florida Statutes) and, as a condition of this Permit, Permittee promises, covenants and agrees that neither Permittee, nor anyone claiming by, through or under Permittee, shall have any claim or cause of action against District by reason of such loss or damage. The parties hereto further acknowledge and agree that District has no obligation to allow Permittee to enter upon or use District's property or right-of-way, and does so only in consideration of Permittee's release of District from any responsibility or liability whatsoever, including for damage caused by District's negligence, now or in the future, and Permittee agrees that it is able, at its own expense, to insure against loss or damage, without granting any right of subrogation to claims against District or Permittee.

20. This Permit may not be assigned or subletted to a third party and any transfer of Permittee's property abutting District's property or right-of-way shall, ipsofacto and without more, cancel, nullify and revoke this Permit.

21. Permittee understands, acknowledges and agrees that the business of the District is digging within the area of its rights of way and sole responsibility for damage to any facilities, structures or property located underground is Permittee's and not the District's.

22. In consideration of the grant of this Permit, Permittee, if a public or private body with the power of eminent domain, expressly waives and relinquishes power of eminent domain or condemnation of the property as to which this Permit applies for the use for which the Permit is granted. This clause shall survive termination or expiration of this Permit.

IN WITNESS WHEREOF, said District has caused these present t be executed in its name by its Secretary and its corporate seal hereto affixed, by due authority of its Board of Supervisors, this ____ day of _____, 2016.

Signed, sealed and delivered
in the presence of:

as to District

(SEAL)

**INDIAN RIVER FARMS WATER
CONTROL DISTRICT**

By: _____
David E. Gunter, Secretary

Permittee hereby accepts the terms of this Permit, and covenants and agrees that it will
comply with the terms and condition of this Permit.

Dated this _____ day of _____, 2016.

Signed, sealed and delivered
in the presence of:

as to Permittee


CITY OF VERO BEACH

By: _____
Mayor

Attest: _____
City Clerk

(SEAL)

| CITY OF VERO BEACH | APPROVED | DATE |
|--------------------|----------|---------|
| City Manager | | |
| City Attorney | WR | 1/2/16 |
| City Clerk | | |
| Utilities - ELC | TF | 1-12-16 |
| Public Works | | |
| Finance | | |
| Human Resources | | |
| Planning | | |
| | | |
| | | |

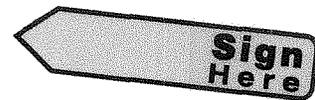




North

VB-2, VB-5, VB-6
INDIAN RIVER FARMS PERMITS
CITY OF VERO BEACH
TRANSMISSION LINES ON
INDIAN RIVER FARMS RIGHT-OF-WAY

ATTACHMENT PROVIDED BY COVB
FOR MUNICIPAL PURPOSES
MARCH 2011

DWG: DVA APP: JD/LTR
DATE: 09/26/01

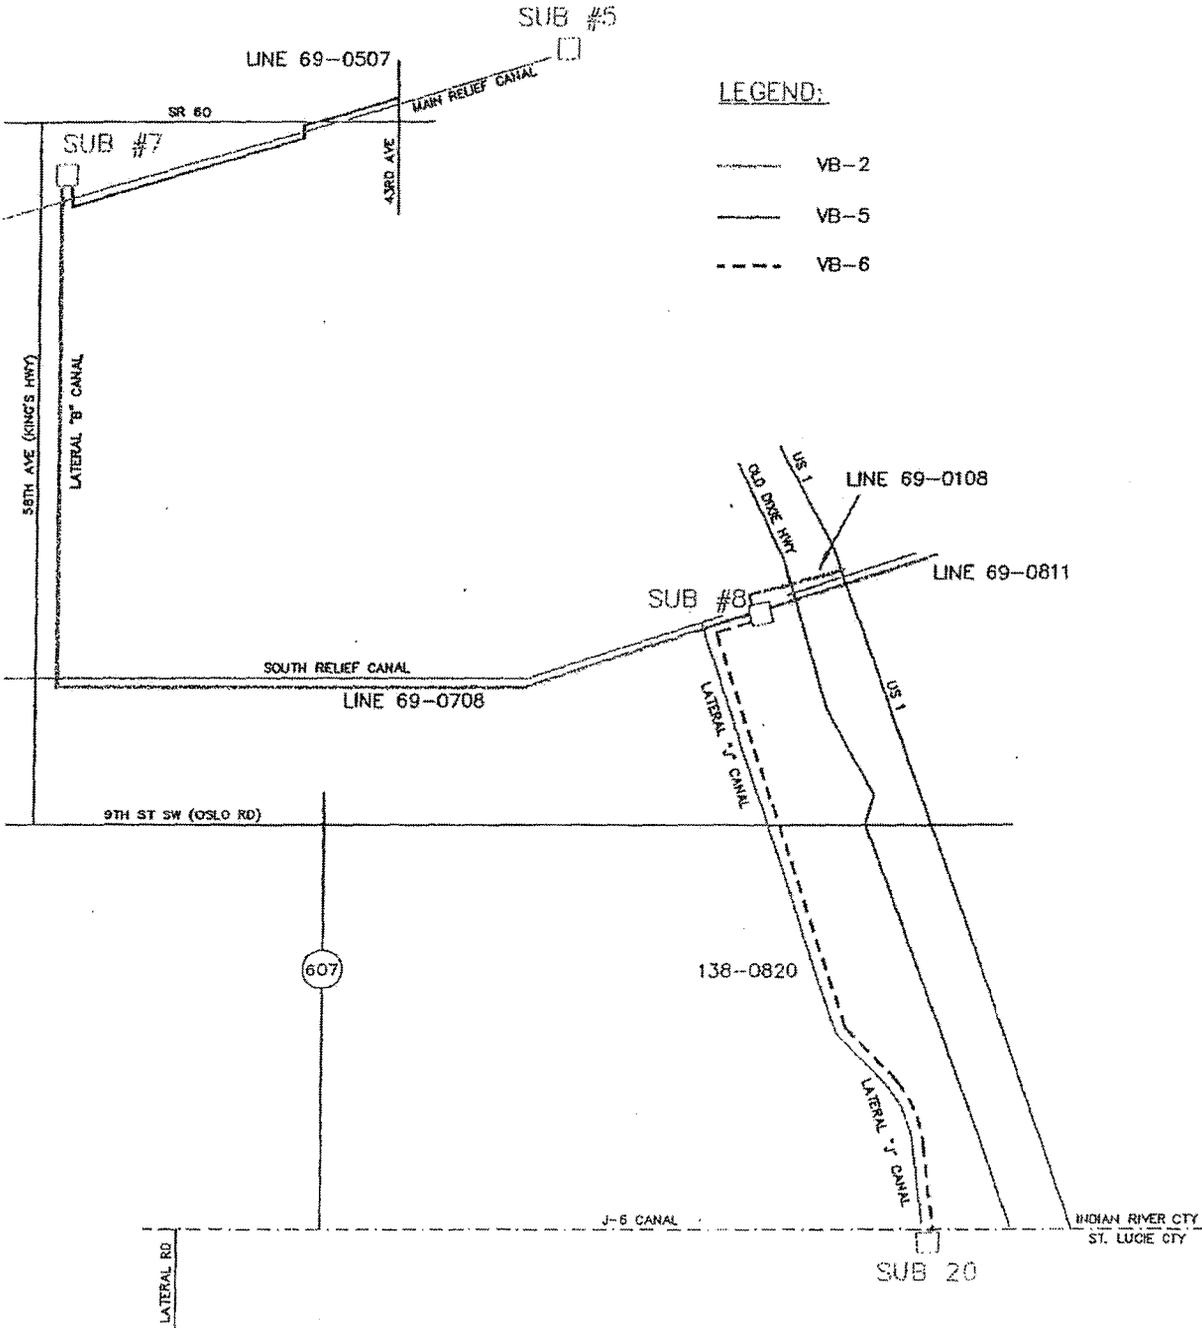

LEGEND:

- VB-2
- - - VB-5
- · · VB-6

PERMIT AND INTERLOCAL AGREEMENT

(No. VB-6)

THIS PERMIT and INTERLOCAL AGREEMENT, dated this 1st day of January, 2016, by and between **INDIAN RIVER FARMS WATER CONTROL DISTRICT**, a drainage district organized and existing under the General Drainage Laws of the State of Florida, whose address is 7305 4th Street, Vero Beach, Florida, hereinafter referred to as the "District", and the **CITY OF VERO BEACH**, a municipal corporation of the State of Florida, hereinafter referred to as the "Permittee".

NOW, THEREFORE, the District does hereby grant unto the Permittee a permit for a period of one year from January 1, 2016 until December 31, 2016, unless sooner terminated as hereinafter provided, to maintain, inspect, operate and repair a 138 kilovolt transmission line and appurtenances on, over and across District right-of-way along the Westerly right-of-way for Lateral "J" Canal from the intersection of a westward projection of 3rd Street, S.W., with Lateral "J" right-of-way South to Oslo Road; thence to the East side of Lateral "J" right-of-way; and then South along the East right-of-way of Lateral "J" to District's J-5 Sub-lateral Canal; and also along the Northerly five feet (5') of District's right-of-way for dike or levee running West along the South Indian River County line from 12th Avenue, SW to 27th Avenue, all as shown on plans prepared by Black & Veatch, Consulting Engineers, identified as their project No. 17807/17869, and extending 3.52 miles, more or less, together with the right of ingress and egress on and over the property at said locations; provided, however, that as a condition precedent to the rights herein granted, Permittee agrees to and with the District as follows:

1. That the construction and installation the transmission lines has been in exact conformity with the as-built plans prepared by Black & Veatch, Consulting Engineers, Project No. 17807/17869.

2. That the rights hereby granted shall extend to a width of ten (10) feet at the location in accordance with said plans. The rights shall extend only for electrical transmission lines used exclusively by the Permittee and belonging to the Permittee and the Permittee shall not have any right to assign or sublet this Permit or any part thereof unto a third part.

3. Permittee assumes full responsibility for the operation and maintenance of said transmission lines and shall save and hold harmless District from any expense, loss, damage or claim in regard thereto, and the District assumes and shall have no liability in connection therewith.

4. District makes no warranty or representation as to the suitability or rights to the use of its rights-of-way for any purposes other than water control and, should this Permit or District's grant of the right to Permittee to use District's right-of-way be challenged, Permittee promises and agrees to pay all of District's cost of defending any such challenge, saving and holding District harmless from any cost or expense, including attorney's fees, in connection therewith.

5. That this Permit is subject always to the paramount right of the District to keep and maintain its drainage district functions and operations, and is subject to revocation and cancellation upon thirty days' notice from District to the City and Permittee.

6. In no event shall the District be liable for any damages done or caused by the District to the public, to Permittee or any other person, using right-of-way or property subject to this Permit, and Permittee shall save the District, its officers, agents, supervisors, and employees harmless from any costs, charge or expense or claim or demand of any person against the District, to the extent permitted by law and subject to the limits provided by Section 768.28, Florida Statutes, arising from or pertaining to any use by Permittee made of the property or structures subject to the Permit. Permittee shall, as a condition to the effectiveness of this Permit, provide to District evidence satisfactory to District, of adequate commercial general liability insurance providing all risks coverage which protects Permittee and the District, its officers, agents, supervisors, and employees for any and all claims and liabilities for bodily injury and property damage arising from Permittee operations of its use of the District right-of-way or property subject to this Permit. Coverage shall be provided in a form no more restrictive than the latest edition of the commercial general liability policy filed by the Insurance Services office. Policies shall be endorsed to name District as an additional insured and shall include provision for at least thirty (30) days advance notice to District by the insurer prior to any policy change, amendment, termination, or expiration of coverage. Permittee shall direct its insurance agent to provide District with a policy, an additional insured endorsement containing language no less restrictive than ISO Form CG 20 10 07 04 or ISO Form CG 20 33 07 04, and a certificate of insurance. This Permit shall be null and void if adequate insurance is not maintained by the Permittee.

7. The District may, on thirty days' written notice to the Permittee, require cessation of use into District's facilities, removal or alteration of any installation or construction on District right-of-way.

8. Any construction on District right-of-way or property and cleanup shall be completed promptly by Permittee and in a workmanlike manner with minimum disturbance to existing berm, channel slopes and grade with proper restoration and planting of any disturbed areas to prevent erosion with ten days after completion of construction or installation

9. The Permittee shall at all times maintain cable markers above ground at 100 foot intervals to show the location of the electrical transmission cables. The electrical transmission lines and utility poles shall be constructed and installed to permit the crossing of heavy equipment used by the District for the maintenance of its laterals, sublaterals, and canals and for any similar heavy equipment used by land owners within the District. In any case where the electrical transmission line crosses a pipe or culvert used for drainage or irrigation purposes, or a pipe or culvert is needed hereafter for drainage or irrigation of adjacent lands, and the same is deemed by District or an adjacent landowner to be required to be installed, repaired or replaced, then upon twenty-four (24) hours' notice, Permittee shall, at Permittee's sole cost and expense, be available at the location of, and arrange for such installation, repair or replacement with personnel and equipment to insure that the transmission line does not endanger or prevent the

installation, repair, replacement or use of pipes or culverts for drainage or irrigation purposes. The District has the right to determine the exact location of each transmission line within the said right-of-way in order that the location of same shall not interfere with the District's functions and operations and of the District land owners.

10. Permittee shall advise District's office prior to commencement or completion of all construction.

11. Permittee shall not discharge any pollutants, contaminants or deleterious materials into waters or structures owned or maintained by, or subject to the jurisdiction of District, nor permit anything to obstruct the flow of water, and shall save and hold District harmless from an expense, loss or damage to District or others by any such discharge or obstruction, remedying or removing the same immediately upon request by District.

12. This Permit shall exist only so long as Permittee may be in full compliance with all requirements of the Department of Environmental Protection for the State of Florida, as such requirements relate to this project, and if, at any time, the Permittee shall fail to meet such requirements, then this Permit shall, ipso facto, immediately become null and void.

13. Permittee, as a condition to the continuance of this Permit, shall reimburse District, immediately on demand, for any fees for testing or other professional services, costs or expenses to District associated with or arising from Permittee's use of District right-of-way.

14. The Permittee shall pay to the District \$5,280.00 rent, for the period of time during which this permit is in effect, at the rate of Fifteen Hundred and No/100 Dollars (\$1,500.00) per year per mile, payable in advance. In addition to the permit fee payable hereunder, if the permit applied for or the use for which the permit is granted requires engineering or legal work for purposes of processing and approval by District, then Permittee shall pay promptly when invoiced all engineering and legal fees incurred by District in connection herewith and shall indemnify District for the same, saving and holding District harmless from any liability in connection therewith.

15. This Permit shall be effective January 1, 2016, and continue for a period of one year unless sooner terminated as provided herein.

16. In the event that this Permit is canceled or terminated, the Permittee shall, at its expense, promptly remove all its property and structures from the right-of-way of the District.

17. This Permit shall be considered to be a license only, for the limited purpose of installation, placement and maintenance of the improvements specified on the face hereof, and does not convey any other right, title or interest of the District in the subject right-of-way property.

18. In the event of any dispute arising hereunder, the parties agree that, as a condition precedent to litigation, the parties shall first submit the same to non-binding mediation with a Florida Circuit Court certified civil mediator with the cost of such mediation shared equally between the parties.

19. Permittee assumes full responsibility for any construction, operation or maintenance on District property or right-of-way subject to the Permit and understands and agrees that Permittee's use of District property for Permittee's purposes and benefit is at Permittee's sole risk; any loss or damage to Permittee's property, installations, facilities or personnel while on District property or right-of-way, regardless of the cause of the same, including, without limitation, negligence or want or care on the part of District, its agents or employees, whether by reason of the provision of Chapter 556, Florida Statutes, or otherwise, is Permittee's and not District's (except as may be otherwise provided by Section 768.28, Florida Statutes) and, as a condition of this Permit, Permittee promises, covenants and agrees that neither Permittee, nor anyone claiming by, through or under Permittee, shall have any claim or cause of action against District by reason of such loss or damage. The parties hereto further acknowledge and agree that District has no obligation to allow Permittee to enter upon or use District's property or right-of-way, and does so only in consideration of Permittee's release of District from any responsibility or liability whatsoever, including for damage caused by District's negligence, now or in the future, and Permittee agrees that it is able, at its own expense, to insure against loss or damage, without granting any right of subrogation to claims against District or Permittee.

20. This Permit may not be assigned or sublet to a third party and any transfer of Permittee's property abutting District's property or right-of-way shall, ipso facto and without more, cancel, nullify and revoke this Permit.

21. Permittee understands, acknowledges and agrees that the business of the District is digging within the area of its rights of way and sole responsibility for damage to any facilities, structures or property located underground is Permittee's and not the District's.

22. In consideration of the grant of this Permit, Permittee, if a public or private body with the power of eminent domain, expressly waives and relinquishes power of eminent domain or condemnation of the property as to which this Permit applies for the use for which the Permit is granted. This clause shall survive termination or expiration of this Permit.

IN WITNESS WHEREOF, said District has caused these present to be executed in its name by its Secretary and its corporate seal hereto affixed, by due authority of its Board of Supervisors, this ____ day of _____, 2016.

Signed, sealed and delivered
in the presence of:

as to District

(SEAL)

**INDIAN RIVER FARMS WATER
CONTROL DISTRICT**

By: _____
David E. Gunter, Secretary

Permittee hereby accepts the terms of this Permit, and covenants and agrees that it will comply with the terms and condition of this Permit.

Dated this _____ day of _____, 2016.

Signed, sealed and delivered
in the presence of:

as to Permittee

CITY OF VERO BEACH

By: _____
Mayor

Attest: _____
City Clerk



(SEAL)

| CITY OF VERO BEACH | APPROVED | DATE |
|--------------------|----------|---------|
| City Manager | | |
| City Attorney | W/CC | 1/10/16 |
| City Clerk | | |
| Utilities - ELC | TF | 1-12-16 |
| Public Works | | |
| Finance | | |
| Human Resources | | |
| Planning | | |
| | | |
| | | |




North

VB-2, VB-5, VB-6
INDIAN RIVER FARMS PERMITS
CITY OF VERO BEACH
TRANSMISSION LINES ON
INDIAN RIVER FARMS RIGHT-OF-WAY

ATTACHMENT PROVIDED BY COVB
FOR MUNICIPAL PURPOSES
MARCH 2011

DWG: DVA APP: JD/LTR
DATE: 09/26/01

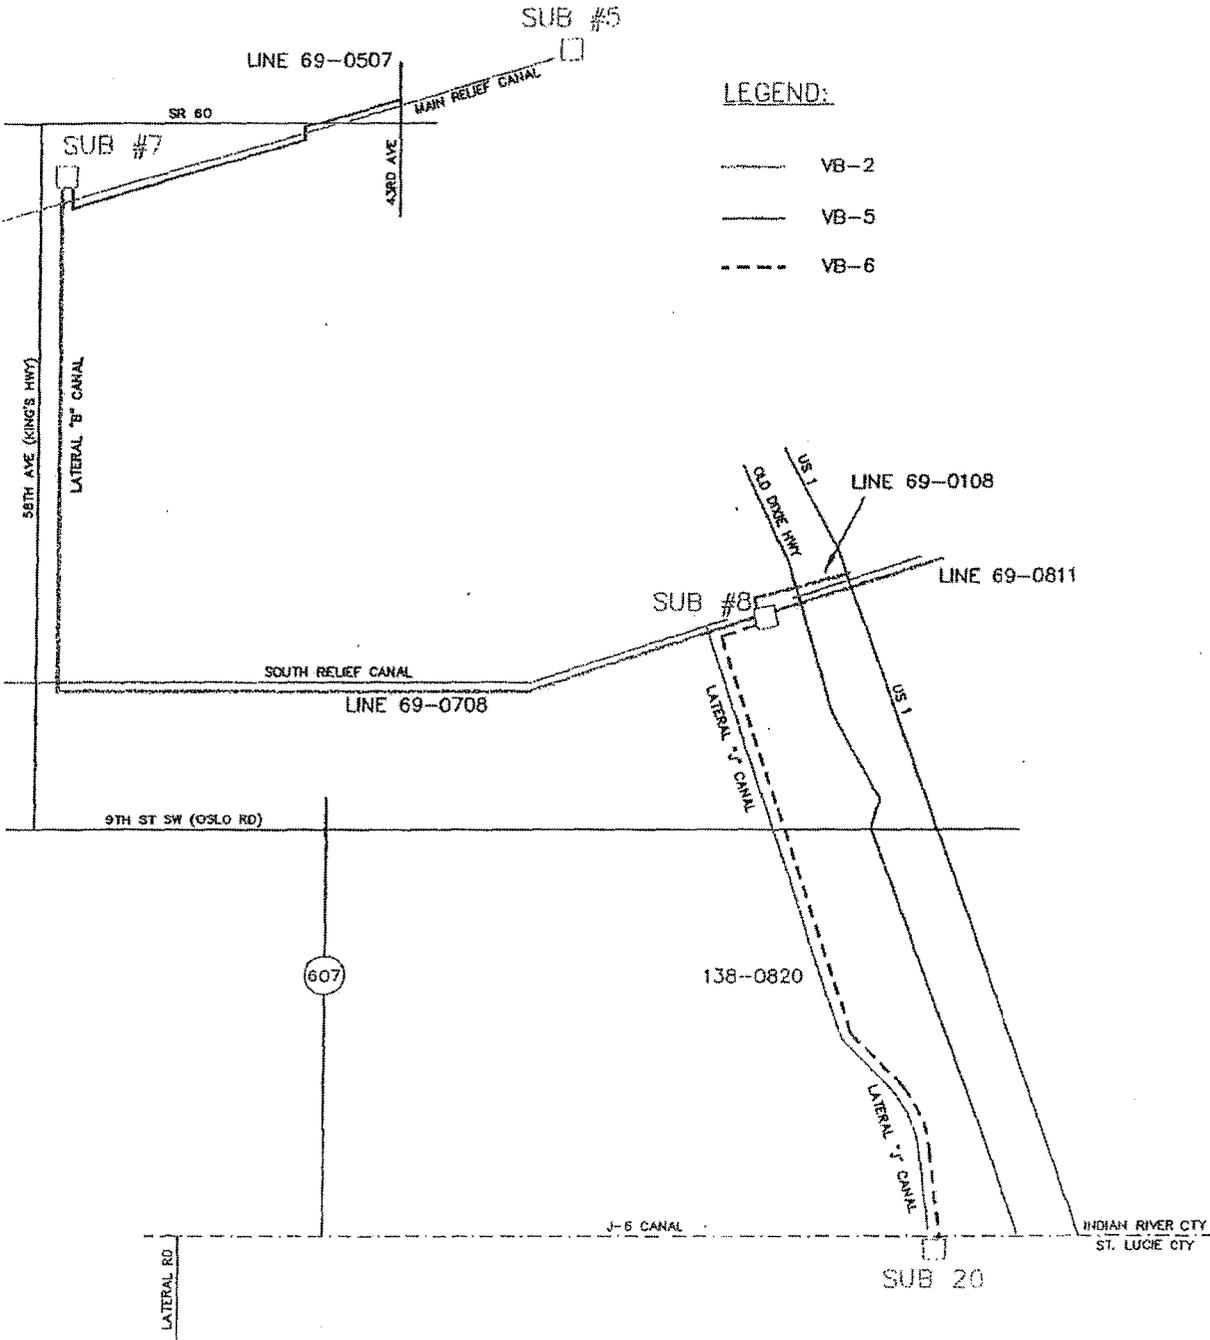

LEGEND:

- VB-2
- - - VB-5
- - - VB-6

PERMIT AND INTERLOCAL AGREEMENT

(No. VB-7)

THIS PERMIT and INTERLOCAL AGREEMENT, dated as of the 1st day of January, 2016, by and between **INDIAN RIVER FARMS WATER CONTROL DISTRICT**, a drainage district organized and existing under the General Drainage Laws of the State of Florida, whose address is 7305 4th Street, Vero Beach, Florida, hereinafter referred to as the "District", and the **CITY OF VERO BEACH**, a municipal corporation of the State of Florida, hereinafter referred to as the "Permittee".

NOW, THEREFORE, the District does hereby grant unto the Permittee a permit for a period of one year from January 1, 2016, unless sooner terminated as hereinafter provided, to maintain, inspect, operate and repair a 24" diameter reuse line on, over and across District right-of-way of the Main Canal at Country Club Drive to Indian River Boulevard, for a distance of approximately 2,316 lineal feet at the locations and in accordance with the plans and specifications attached hereto and marked "Exhibit A" and signed by the parties and, by reference, made a part hereof, together with the right of ingress and egress on and over the property at said locations; provided, however, that as a condition precedent to the right herein granted, Permittee agrees to and with the District as follows:

1. That the construction and installation of reuse line has been in exact conformity with the as-built plans prepared by Robert J. Bolton, P.E., City of Vero Beach Water & Sewer Department.

2. That the rights shall extend only for reuse line used exclusively by the City of Vero Beach (unless otherwise agreed to by District) and belonging to the Permittee and the Permittee shall not have any right to assign or sublet this Permit or any part thereof unto a third part.

3. Permittee assumes full responsibility for the operation and maintenance of said reuse line and shall save and hold harmless District from any expense, loss, damage or claim in regard thereto, and the District assumes and shall have no liability in connection therewith.

4. That this Permit is subject always to the paramount right of the District to keep and maintain its drainage district functions and operations, and is subject to revocation and cancellation upon thirty days' notice from District to the City and Permittee.

5.. In no event shall the District be liable for any damages done or caused by the District to the public, to Permittee or any other person, using right-of-way or property subject to this Permit, and Permittee shall save the District, its officers, agents, supervisors, and employees harmless from any costs, charge or expense or claim or demand of any person against the District, to the extent permitted by law and subject to the limits provided by Section 768.28, Florida Statutes, arising from or pertaining to any use by Permittee made of the property or structures subject to this Permit. Permittee shall, as a condition to the effectiveness of this Permit, provide to District evidence satisfactory to District, of adequate commercial general liability insurance providing all risks coverage which protects Permittee and the District, its officers, agents, supervisors,

and employees from any and all claims and liabilities for bodily injury and property damage arising from Permittee operations of its use of the District right-of-way or property subject to this permit. Coverage shall be provided in a form no more restrictive than the latest edition of the commercial general liability policy filed by the Insurance Service Office. Policies shall be endorsed to name District as an additional insured and shall include provisions for at least thirty (30) days advance notice to District by the insurer prior to any policy change, amendment, termination, or expiration of coverage. Permittee shall direct its insurance agent to provide District with a policy, an additional insured endorsement containing language no less restrictive than ISO Form CG 20 10 07 04 or ISO Form CG 20 33 07 04, and a certificate of insurance. This Permit shall be null and void if adequate insurance is not maintained by the Permittee.

6. The District may, on thirty days' written notice to the Permittee, require cessation of use within District's right-of-way, together with removal or alteration of any installation or construction on District right-of-way.

7. The Permittee shall at all times maintain cable markers above ground at 100 foot intervals to show the location of any underground objects. The reuse line shall be constructed and installed to permit the crossing of heavy equipment used by the District for the maintenance of its laterals, sub-laterals and canals and for any similar heavy equipment used by land owners within the District. In any case where the reuse line crosses a pipe or culvert used for drainage or irrigation purposes, or a pipe or culvert is needed hereafter for drainage or irrigation of adjacent lands, and the same is deemed by District or an adjacent landowner to be required to be installed, repaired or replaced, then upon twenty-four (24) hours notice, Permittee shall, at Permittee's sole cost and expense, be available at the location of, and arrange for such installation, repair or replacement with personnel and equipment to insure that the reuse line does not endanger or prevent the installation, repair, replacement or use of pipes or culverts for drainage or irrigation purposes. The District has the right to determine the exact location of the reuse line within the said right-of-way in order that the location of same shall not interfere with the District's functions and operations and of the District land owners.

8. Permittee shall advise District's office prior to commencement or completion of all construction.

9. Permittee shall not discharge any pollutants, contaminants or deleterious materials into waters or structures owned or maintained by, or subject to the jurisdiction of District, nor permit anything to obstruct the flow of water, and shall save and hold District harmless from an expense, loss or damage to District or others by any such discharge or obstruction, remedying or removing the same immediately upon request by District.

10. This Permit shall exist only so long as Permittee may be in full compliance with all requirements of the Department of Environmental Protection for the State of Florida, as such requirements relate to this project, and if, at any time, the Permittee shall fail to meet such requirements, then this Permit shall, ipso facto, immediately become null and void.

11. Permittee, as a condition to the continuance of this Permit, shall reimburse District, immediately on demand, for any fees for testing or other professional services, costs or expenses to District associated with or arising from Permittee's use of District right-of-way.

12. The Permittee shall pay to the District an annual rent of Seven Hundred Forty Five and 68/100 Dollars (\$745.68), payable in advance. In addition to the permit fee payable hereunder, if the permit applied for or the use for which the permit is granted requires engineering or legal work for purposes of processing and approval by District, then Permittee shall pay promptly when invoiced all engineering and legal fees incurred by District in connection herewith and shall indemnify District for the same, saving and holding District harmless from any liability in connection therewith.

13. This Permit shall be effective January 1, 2016, and continue for a period of one year unless sooner terminated as provided herein.

14. In the event that this Permit is canceled or terminated, the Permittee shall, at its expense, promptly remove the sewer reuse line from the right-of-way of the District.

15. This Permit shall be considered to be a license only, for the limited purpose of installation, placement and maintenance of the improvements specified on the face hereof, and does not convey any other right, title or interest of the District in the subject right-of-way property.

16. In the event of any dispute arising hereunder, the parties agree that, as a condition precedent to litigation, the parties shall first submit the same to non-binding mediation with a Florida Circuit Court certified civil mediator with the cost of such mediation shared equally between the parties.

17. Permittee assumes full responsibility for any construction, operation or maintenance on District property or right-of-way subject to the Permit and understands and agrees that Permittee's use of District property for Permittee's purposes and benefit is at Permittee's sole risk; any loss or damage to Permittee's property, installations, facilities or personnel while on District property or right-of-way, regardless of the cause of the same, including, without limitation, negligence or want or care on the part of District, its agents or employees, whether by reason of the provision of Chapter 556, Florida Statutes, or otherwise, is Permittee's and not District's (except as may be otherwise provided by Section 768.28, Florida Statutes) and, as a condition of this Permit, Permittee promises, covenants and agrees that neither Permittee, nor anyone claiming by, through or under Permittee, shall have any claim or cause of action against District by reason of such loss or damage. The parties hereto further acknowledge and agree that District has no obligation to allow Permittee to enter upon or use District's property or right-of-way, and does so only in consideration of Permittee's release of District from any responsibility or liability whatsoever, including for damage caused by District's negligence, now or in the future, and Permittee agrees that it is able, at its own expense, to insure against loss or damage, without granting any right of subrogation to claims against District or Permittee.

18. This Permit may not be assigned or sublet to a third party and any transfer of Permittee's property abutting District's property or right-of-way shall, ipso facto and without more, cancel, nullify and revoke this Permit.

19. Permittee understands, acknowledges and agrees that the business of District is digging within the area of its rights of way and sole responsibility for damage to any facilities, structures or property located underground is Permittee's and not the District's.

20. In consideration of the grant of this Permit, Permittee, if a public or private body with the power of eminent domain, expressly waives and relinquishes power of eminent domain or condemnation of the property as to which this Permit applies for the use for which the Permit is granted. This clause shall survive termination or expiration of this Permit.

IN WITNESS WHEREOF, said District has caused these present to be executed in its name by its Secretary and its corporate seal hereto affixed, by due authority of its Board of Supervisors, this ____ day of _____, 2016.

Signed, sealed and delivered
in the presence of:

as to District

(SEAL)

**INDIAN RIVER FARMS WATER
CONTROL DISTRICT**

By: _____
David E. Gunter, Secretary

Permittee hereby accepts the terms of this Permit, and covenants and agrees that it will comply with the terms and condition of this Permit.

Dated this ____ day of _____, 2016.

Signed, sealed and delivered
in the presence of:

as to Permittee

CITY OF VERO BEACH


By: _____
Mayor

Attest: _____
City Clerk



| CITY OF VERO BEACH | APPROVED | DATE |
|-----------------------|------------|-----------------|
| City Manager | | |
| City Attorney | <i>WLB</i> | <i>11/18/16</i> |
| City Clerk | | |
| Utilities - <i>WS</i> | <i>DJB</i> | <i>11/12/16</i> |
| Public Works | | |
| Finance | | |
| Human Resources | | |
| Planning | | |
| | | |

(SEAL)

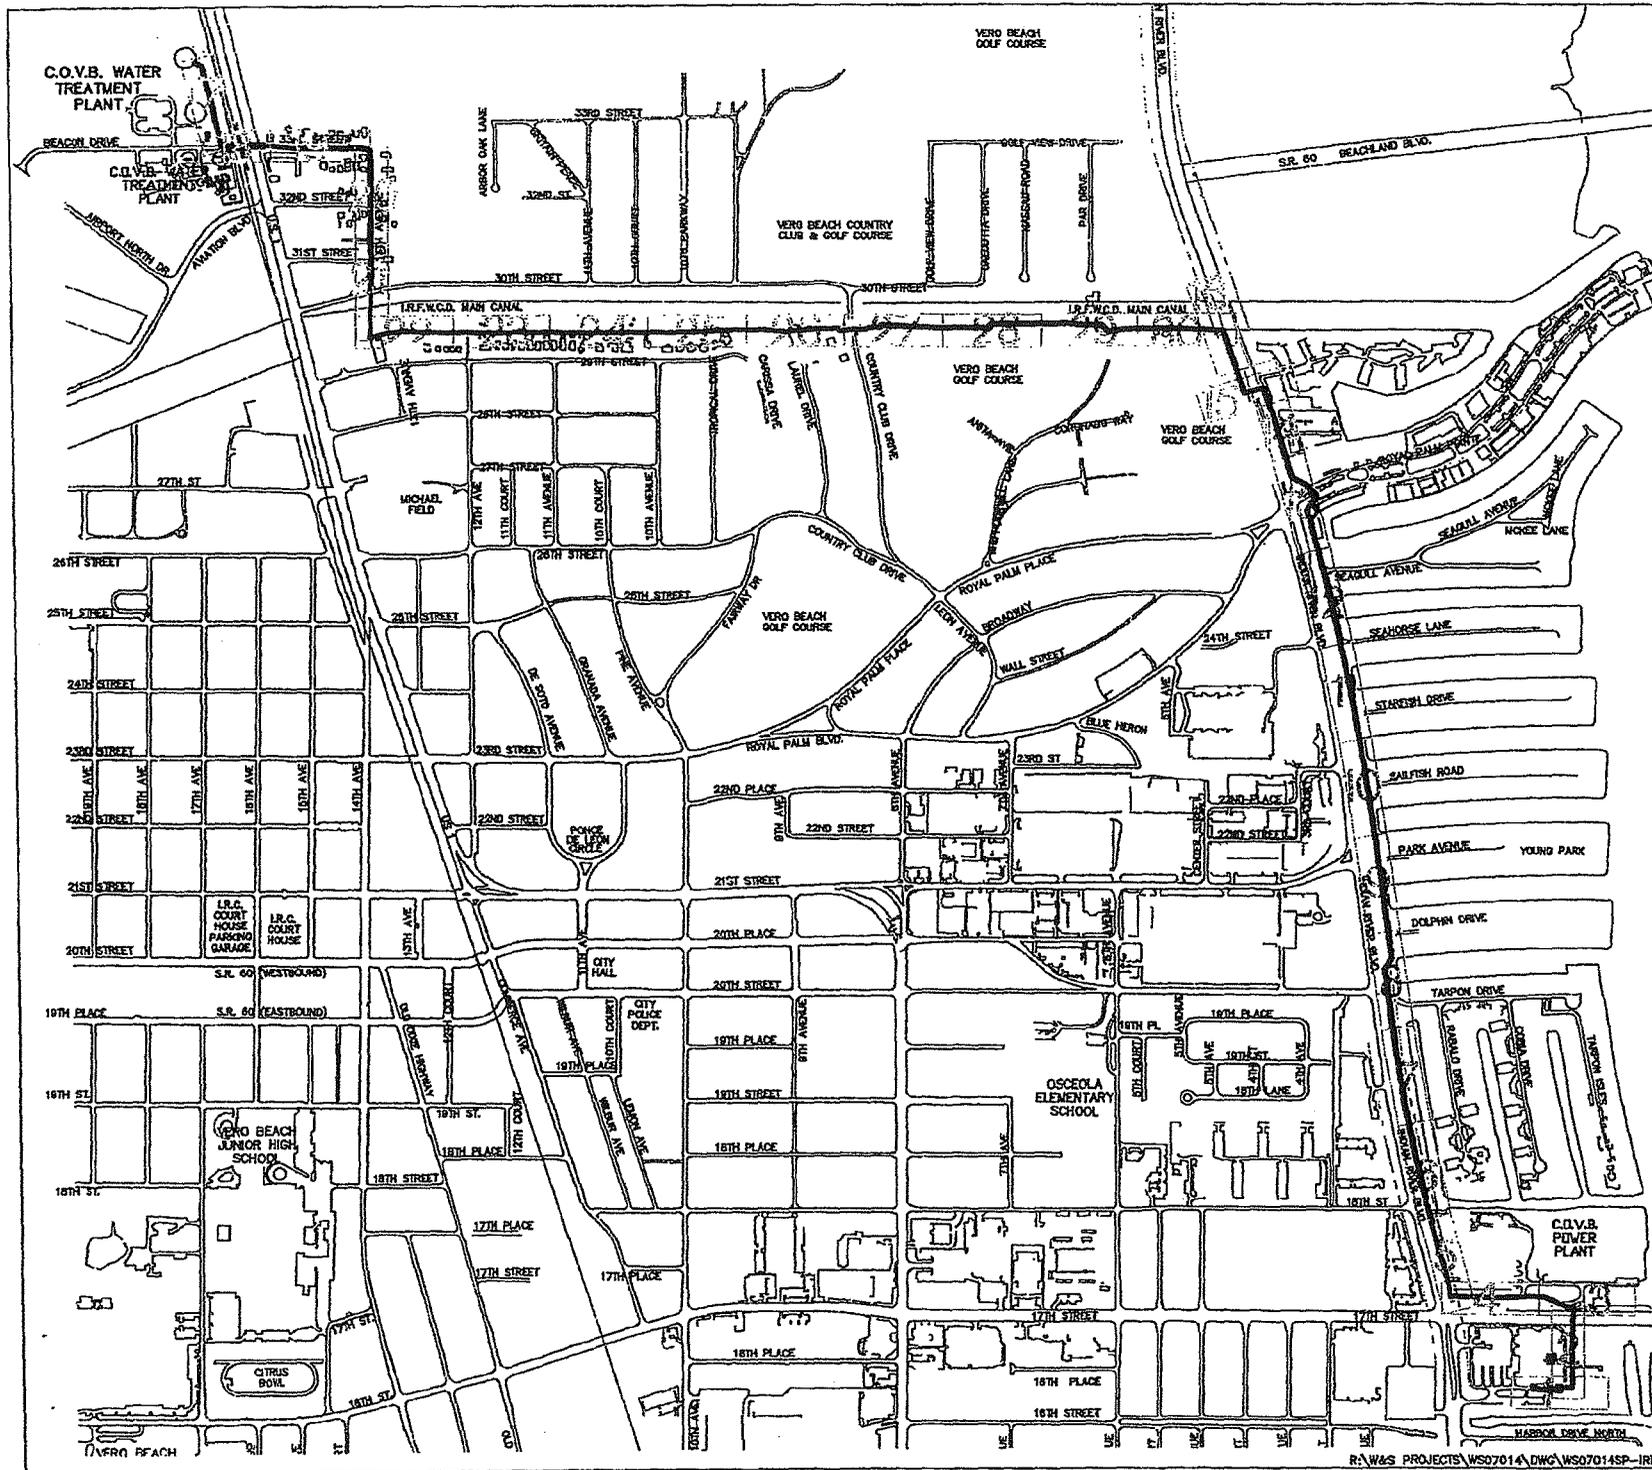

SCALE 1" = 400'


EXHIBIT "A"
(11 pages)

- LEGEND**
- AS-BUILT SHEET NO. 30
 - 24" PVC FM _____
 - 24" HDPE FM _____
 - 24" PVC REUSE WM _____

PLOT DATE: 10/05/2010

| REV. NO. | DESCRIPTION | AUTHORED BY | DRAWN BY | DATE |
|--|--|----------------|-----------------------------------|-----------------|
| | FORCE MAIN FROM C.O.V.B. W.W.T.P. TO W.T.P. AS-BUILT DRAWING | | | |
| | SHEET LAYOUT | SCALE 1" = 20' | DRAWN BY J.A.Y. CHECKED BY R.L.B. | DATE 11/17/2010 |
| CITY OF VERO BEACH WATER AND SEWER DEPARTMENT | | | | |
| CITY PROJECT NO. WS07014 | | | | SHEET 1 OF 1 |

Handwritten signature and date: 10/17/10
 ROBERT J. BARTON, P.E. P. 19428

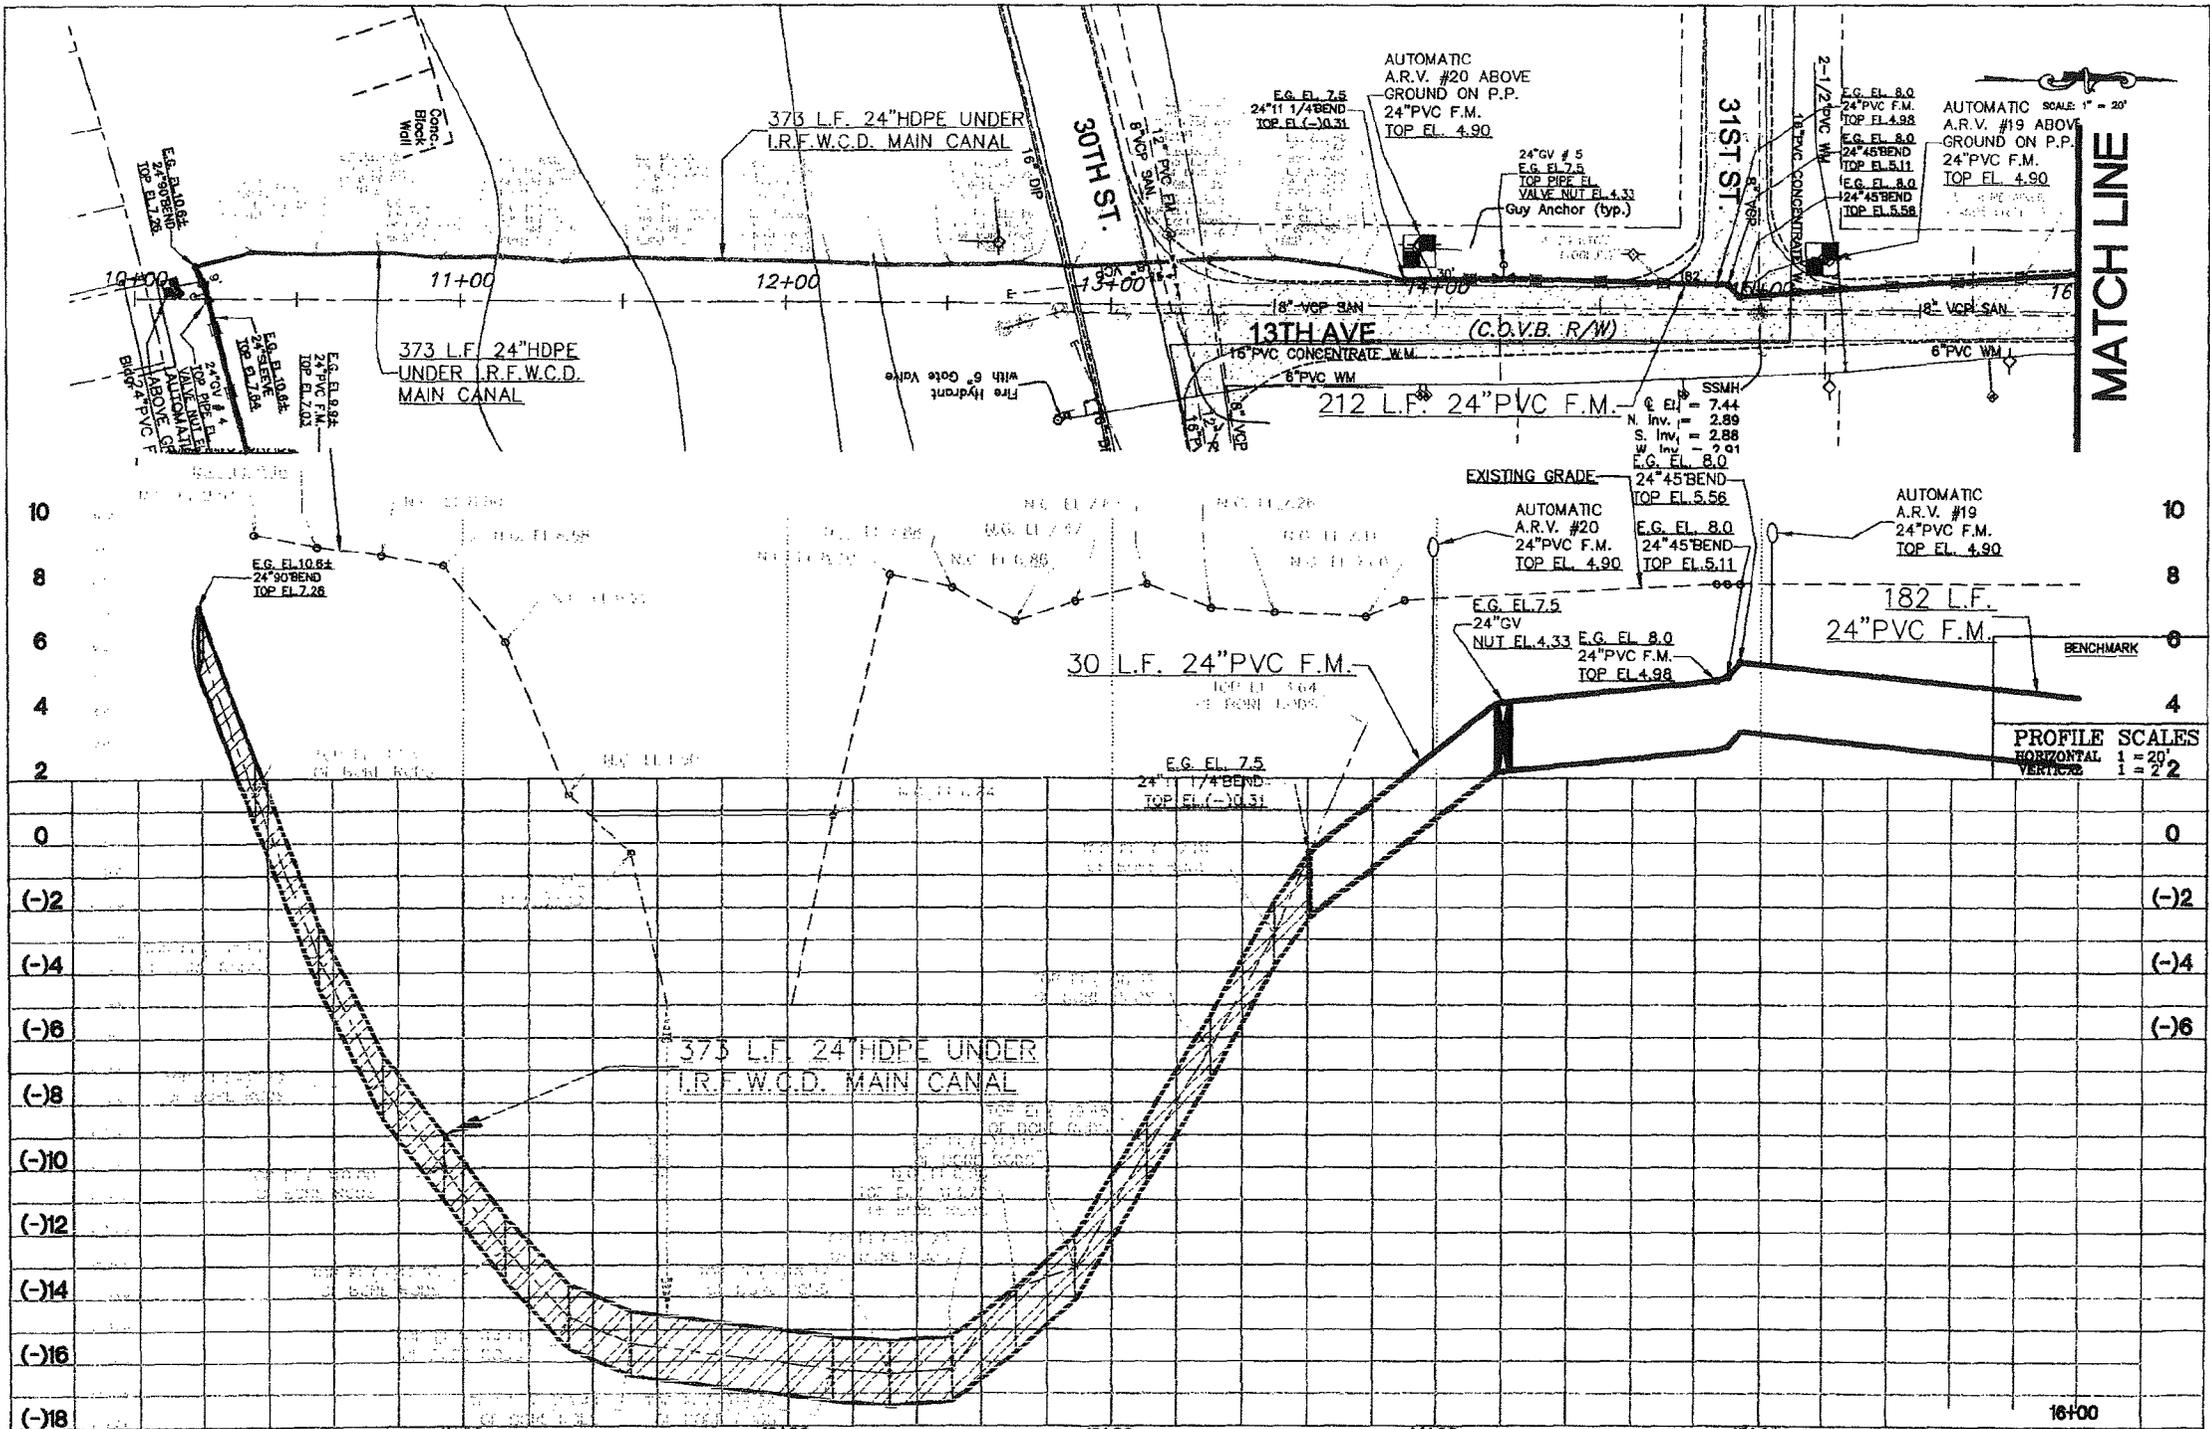

MATCH LINE

PROFILE SCALES
 HORIZONTAL 1" = 20'
 VERTICAL 1" = 2' 2"



| | | | | | | | | |
|--|-------|-------|------------|----------|-----------|--|-------|------------------------------------|
| 10+00 | 14+00 | 18+00 | 22+00 | 26+00 | 30+00 | 34+00 | 38+00 | 42+00 |
| AS-BUILT INFO. FIELD NOTES & SURVEY | | | R.I.B. | T.A.Y. | 8/13/2010 | FORCE MAIN FROM C.O.V.B. W.W.T.P. TO W.T.P. | | |
| DESCRIPTION | | | AUTHZD. BY | DRAWN BY | DATE | AS-BUILT DRAWING | | |
| CITY OF VERO BEACH WATER AND SEWER DEPARTMENT | | | | | | PLAN & PROFILE - C.O.V.B. W.W.T.P. STA. 10+00 - 16+00 | | ROBERT J. BELTON, P.E. FL. # 49429 |
| | | | | | | DATE: 8/12/2010 | | CITY PROJECT NO. WS07014 |
| | | | | | | | | SHEET 21 of 30 |

of. = 1.85

SCALE 1" = 20'

I.R.F.W.C.D. MAIN CANAL

MATCH LINE

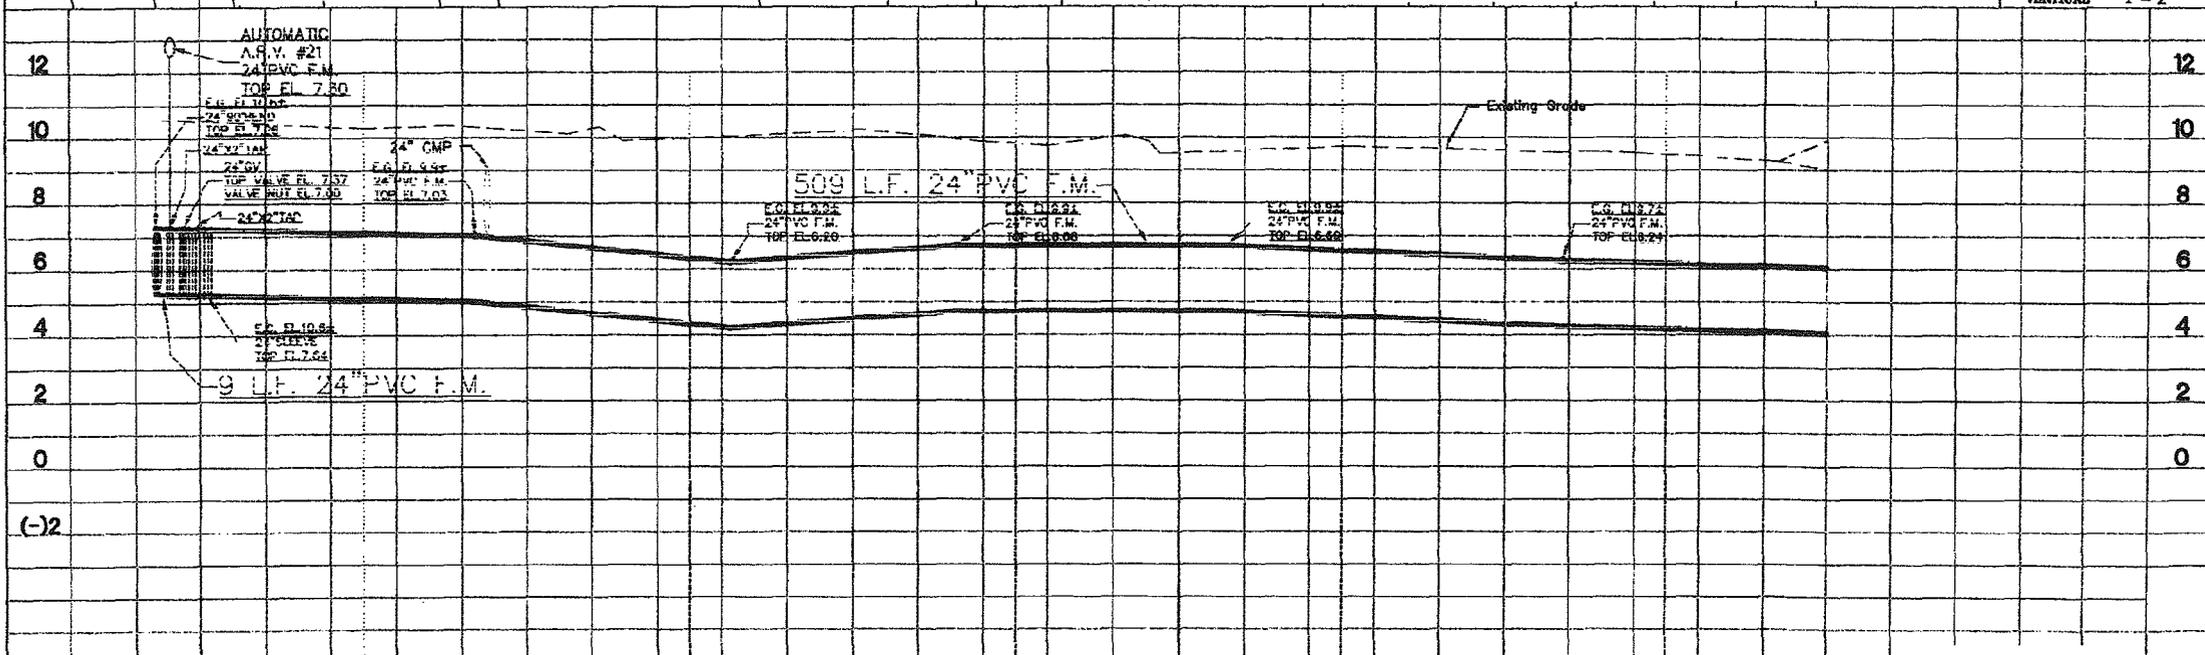
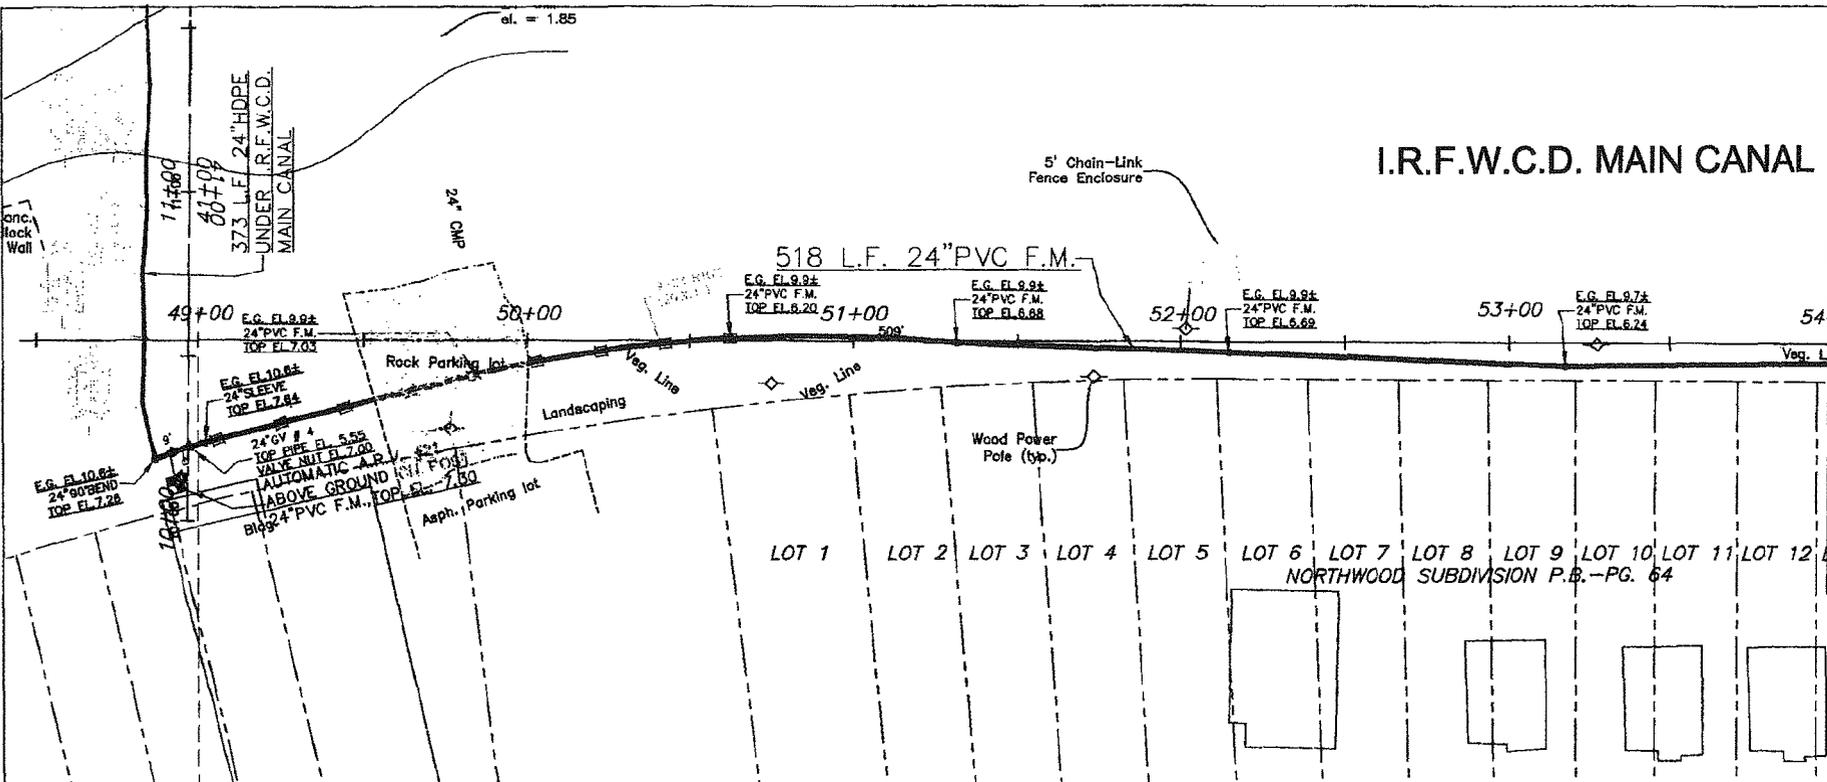


| | |
|----------------|----------|
| BENCHMARK | |
| PROFILE SCALES | |
| HORIZONTAL | 1" = 20' |
| VERTICAL | 1" = 2' |

MATCH LINE

MATCH LINE

SCALE 1" = 20'

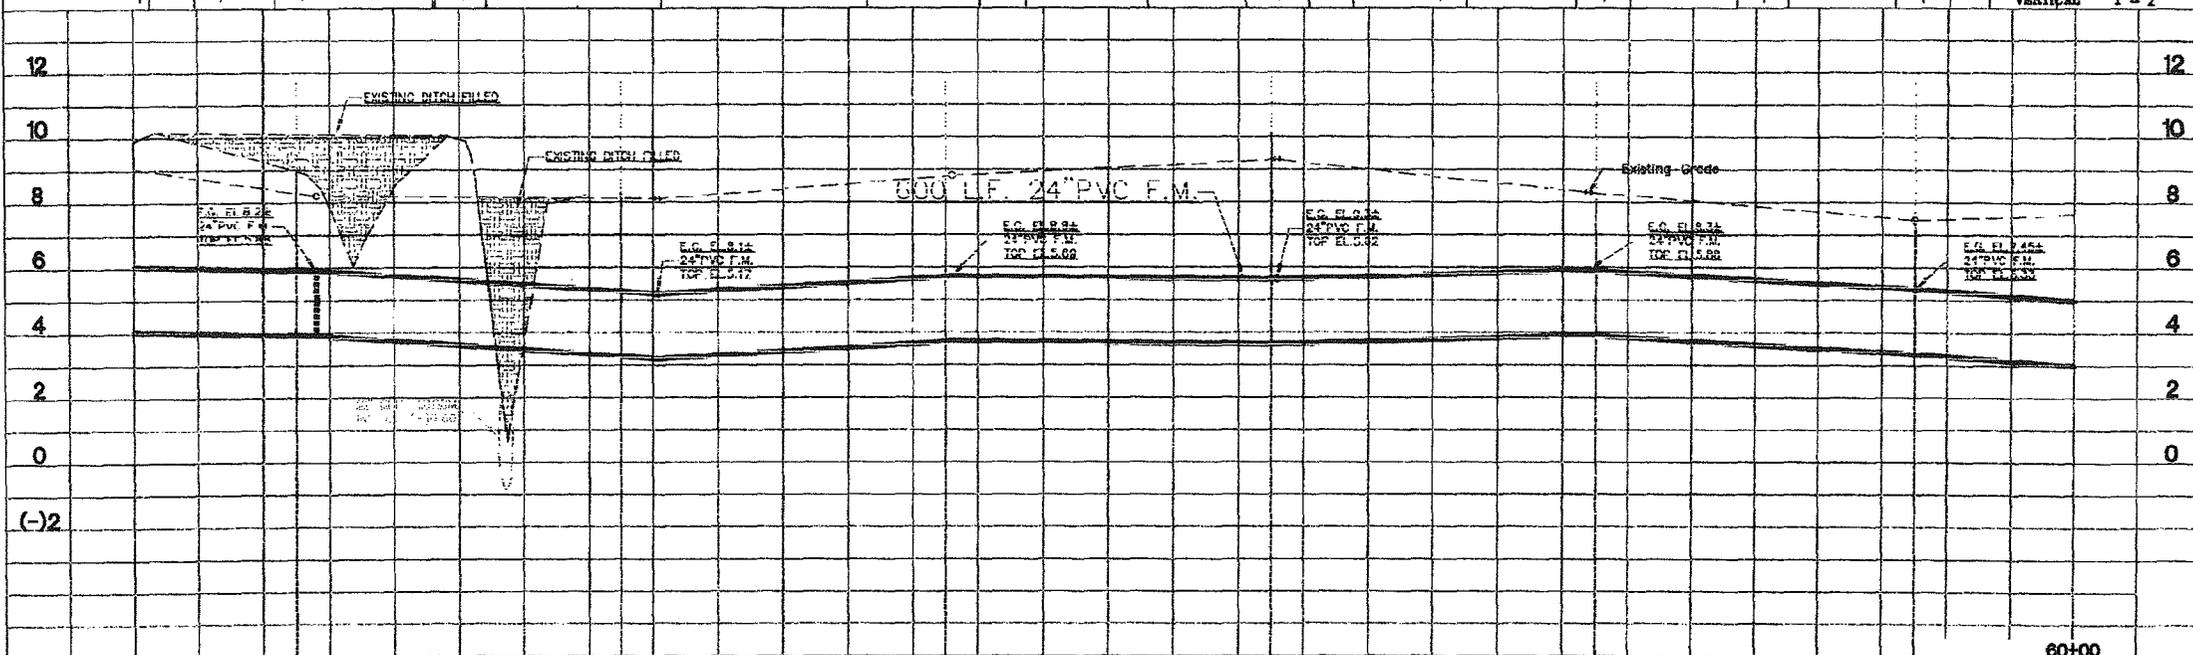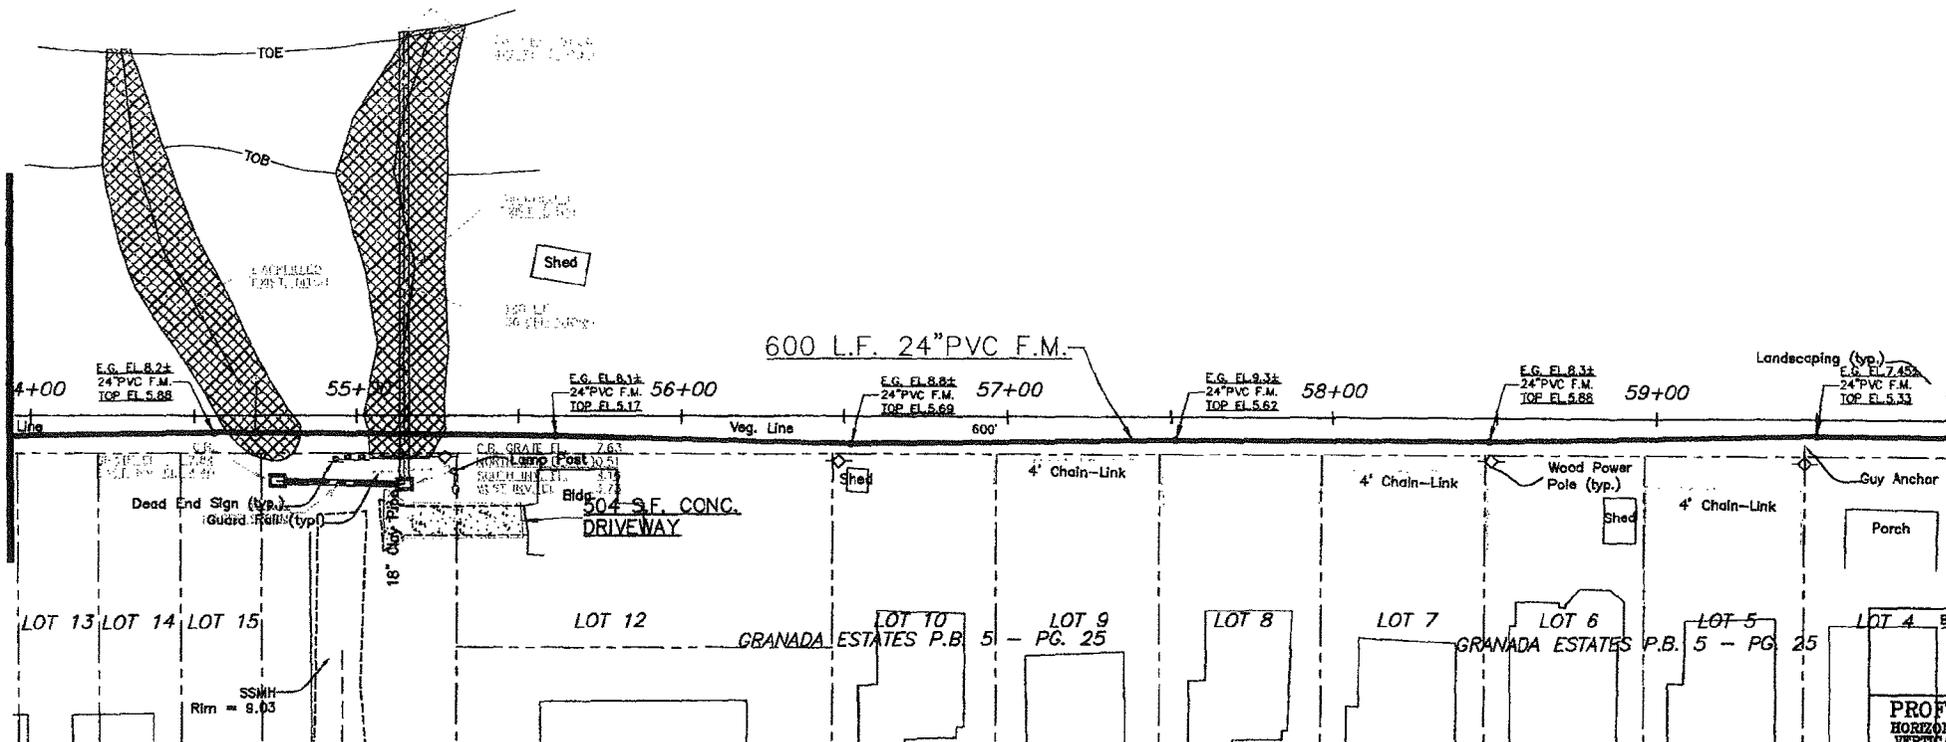


| | | | | | | |
|--|-------|--------------------------|-------|--|-------|----------------------------|
| 54+00 | 55+00 | 56+00 | 57+00 | 58+00 | 59+00 | 60+00 |
| A AS-BUILT INFO. FIELD NOTES & SURVEY | | R.L.B. T.A.Y. 18/13/2010 | | CITY OF VERO BEACH WATER AND SEWER DEPARTMENT | | PLANNING & DESIGN DIVISION |
| DESCRIPTION | | AUTHORZD BY | | DRAWN BY | | DATE |
| FORCE MAIN FROM C.O.V.B. W.W.T.P. TO W.T.P. AS-BUILT DRAWING | | | | PLAN & PROFILE - I.R.F.W.D. MAIN CANAL R.O.W. STA. 54+00 - 60+00 | | DATE 12/12/2010 |
| REV. NO. | | | | R.I.B. | | SHR27.3op.30 |

I.R.F.W.C.D. MAIN CANAL


MATCH LINE

MATCH LINE



SCALE 1" = 20'

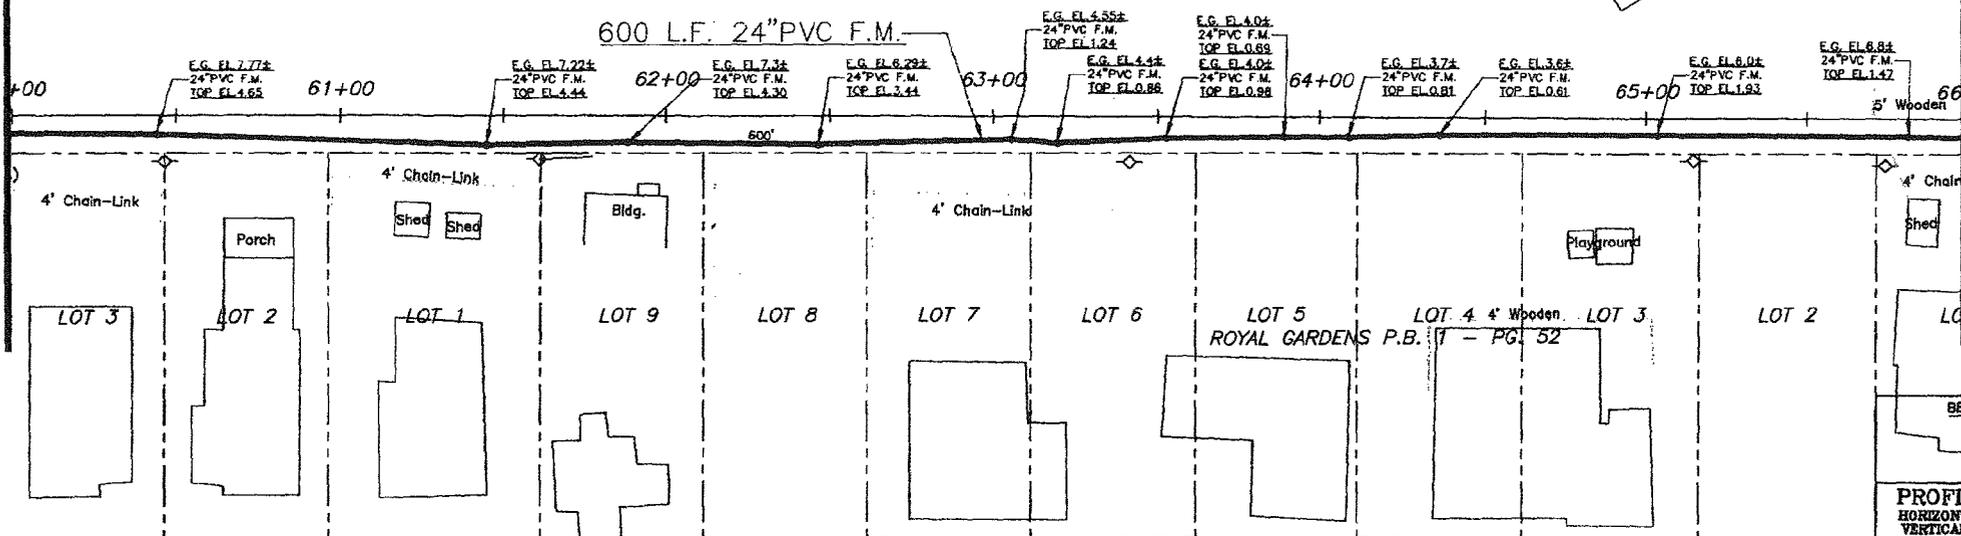

PROFILE SCALES
 HORIZONTAL 1" = 20'
 VERTICAL 1" = 2'

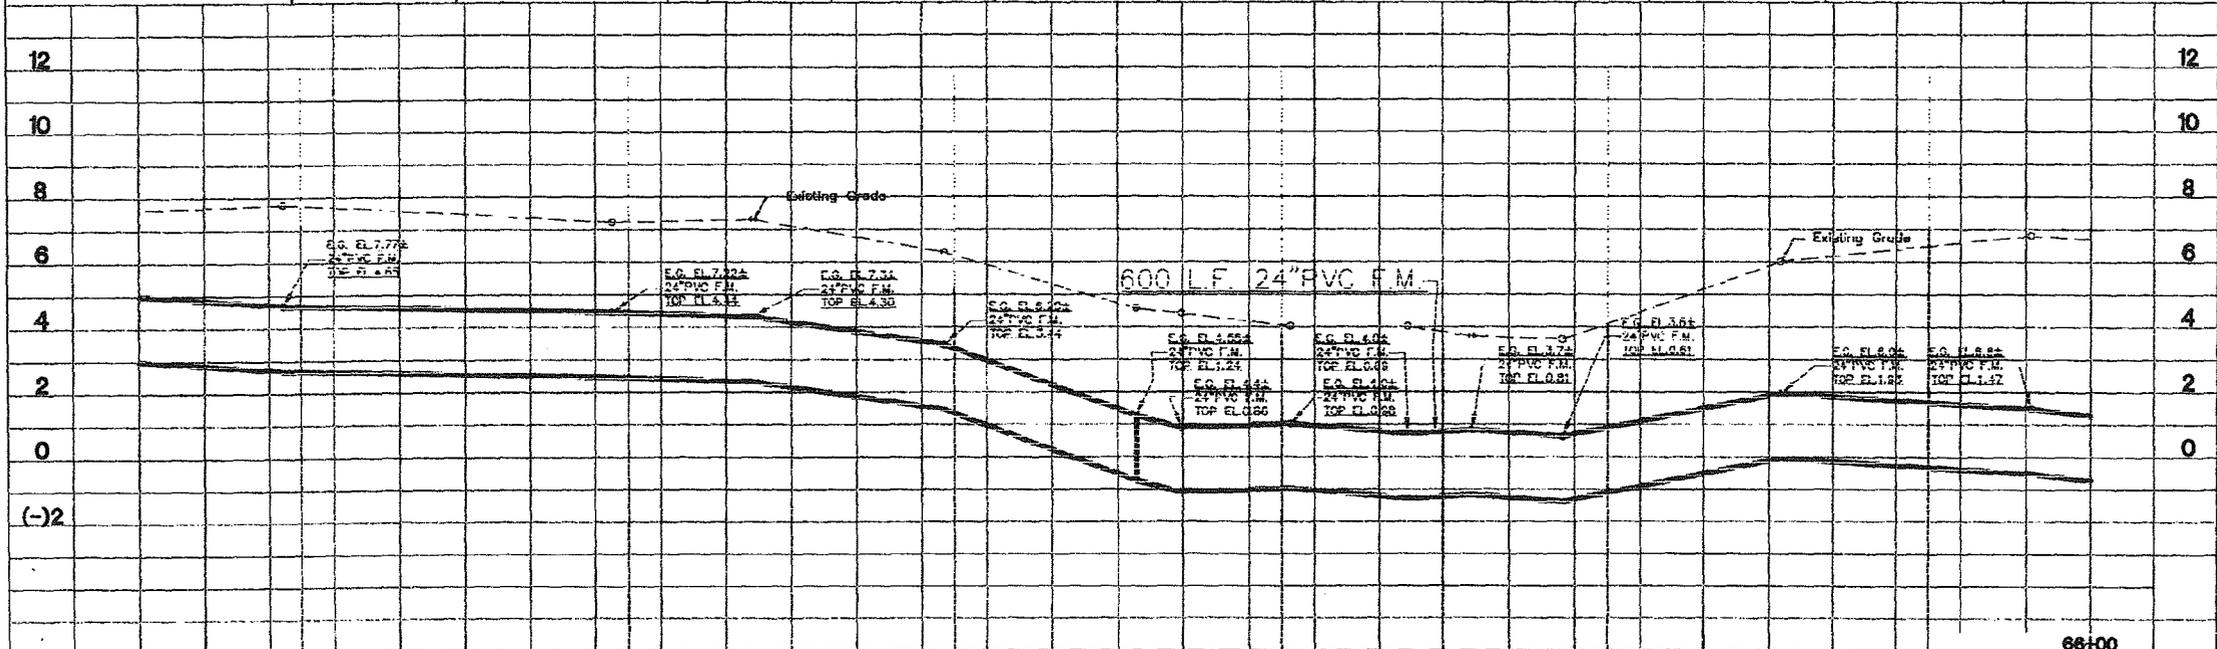

| | | | | | | |
|---|-------|---------------|----------------------------|-----------|---|---|
| 60+00 | 61+00 | 62+00 | 63+00 | 64+00 | 65+00 | 66+00 |
| A AS-BUILT INFO, FIELD NOTES & SURVEY | | R.J.B. | T.A.Y. | 8/13/2010 | | ROBERT J. MILTON, P.E. FL. 945489 DATE: |
| DESCRIPTION | | AUTHORIZED BY | DRAWN BY | DATE | | |
| FORCE MAIN FROM C.O.V.B. W.W.T.P. TO W.T.P. | | | CITY OF VERO BEACH | | PLAN & PROFILE - I.R.F.W.D. MAIN CANAL R.O.W. T.A.Y. 8/21/2010 CITY PROJECT | |
| AS-BUILT DRAWING | | | WATER AND SEWER DEPARTMENT | | STA. 60+00 - 66+00 R.J.B. NO. WS07014 SHEET 24 of 30 | |

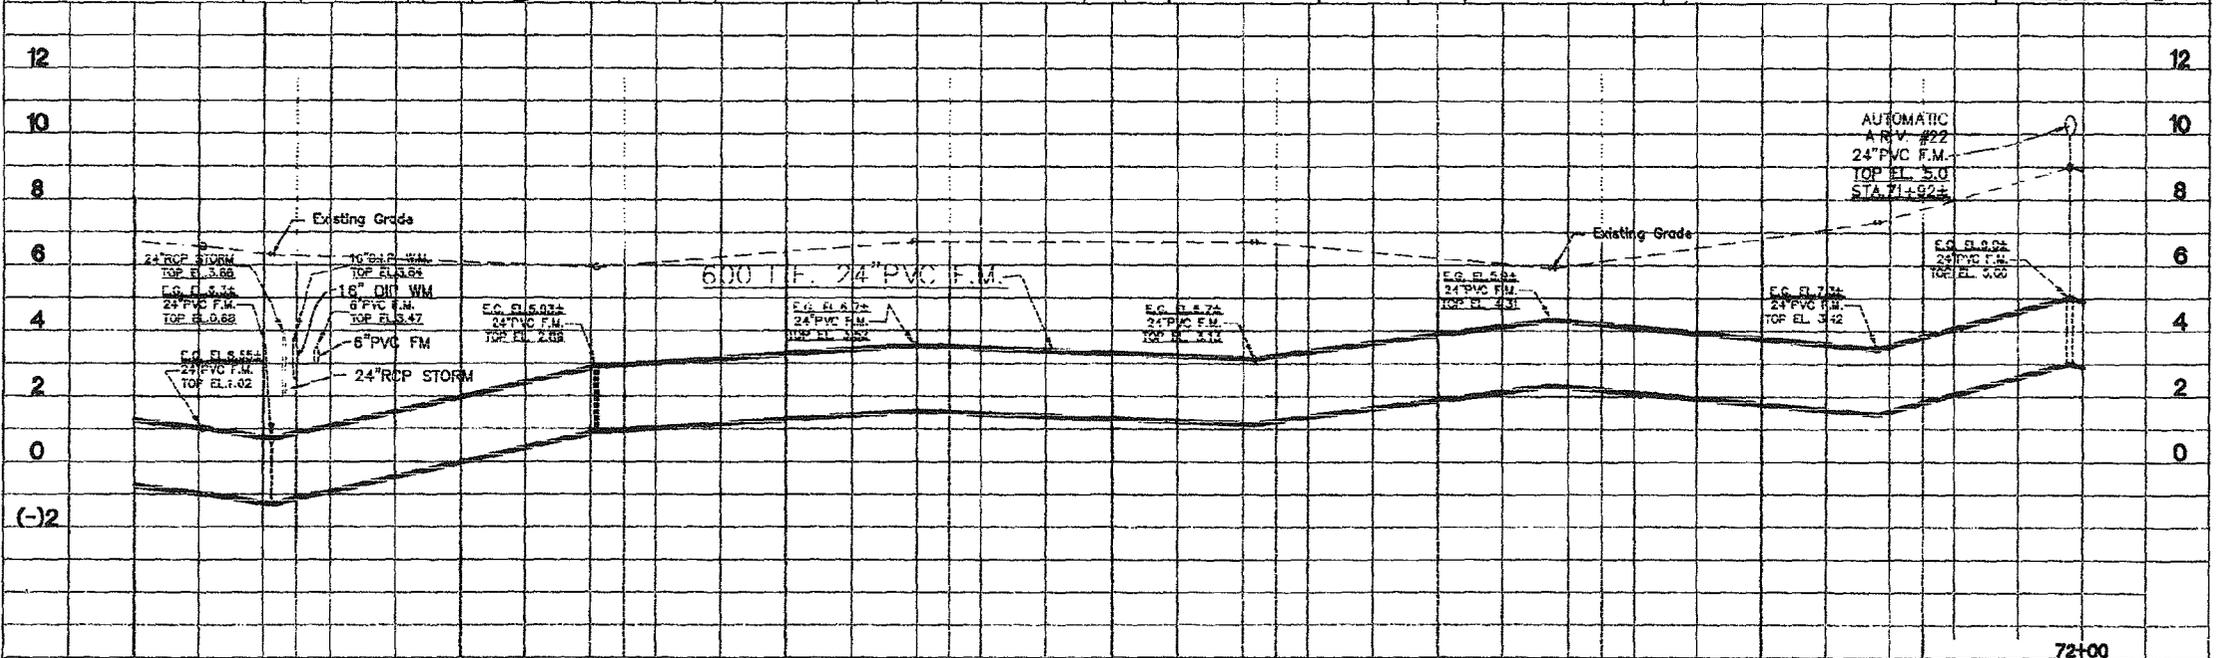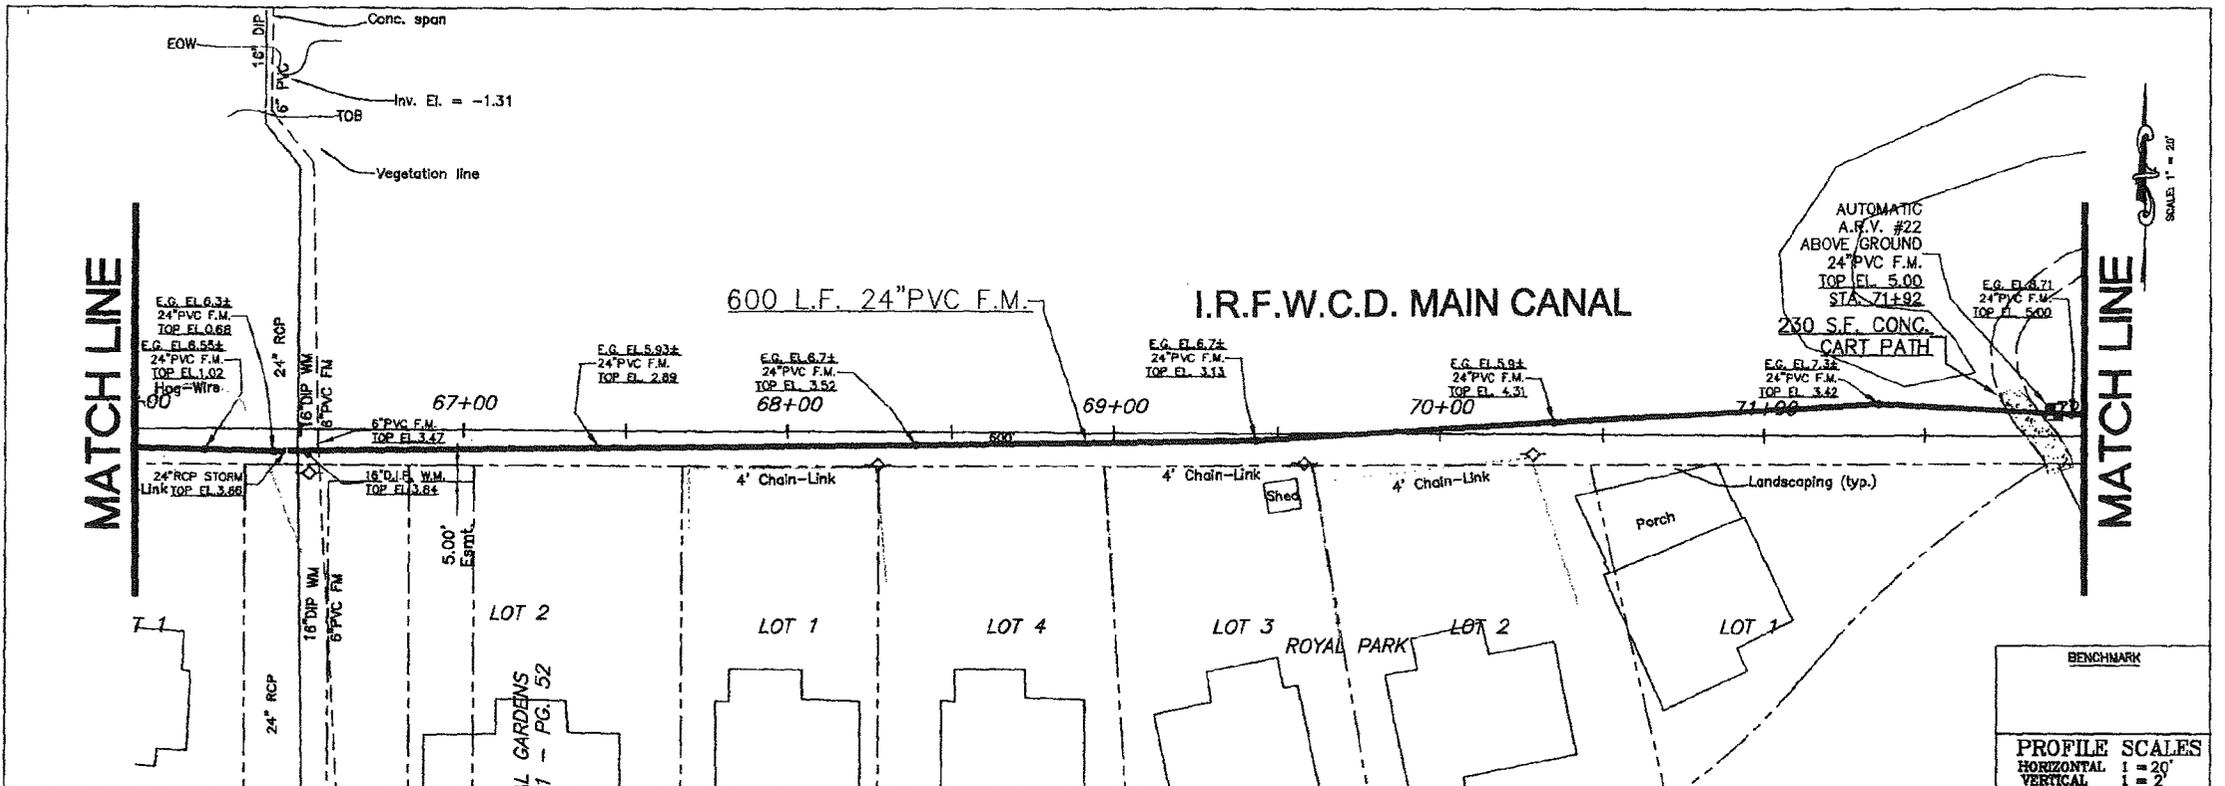


| | | | | | | | | | |
|--|-------------|---------------|----------|-------|--|-------|---|--------|-----------|
| 66+00 | 67+00 | 68+00 | 69+00 | 70+00 | 71+00 | 72+00 | ROBERT J. BOLTON, P.E. FL # 49429 | DATE: | |
| A AS-BUILT INFO, FIELD NOTES & SURVEY | | | | | | | R.J.B. | T.A.Y. | 8/13/2010 |
| REV. NO. | DESCRIPTION | AUTHORIZED BY | DRAWN BY | DATE | FORCE MAIN FROM C.O.V.B. W.W.T.P. TO W.T.P. AS-BUILT DRAWING | | CITY OF VERO BEACH WATER AND SEWER DEPARTMENT | | |
| PLAN & PROFILE - I.R.F.W.D. MAIN CANAL R.O.W. STA. 66+00 - 72+00 | | | | | | | NO. WS07014 | | |

I.R.F.W.C.D. MAIN CANAL

SCALE: 1" = 20'

MATCH LINE


MATCH LINE

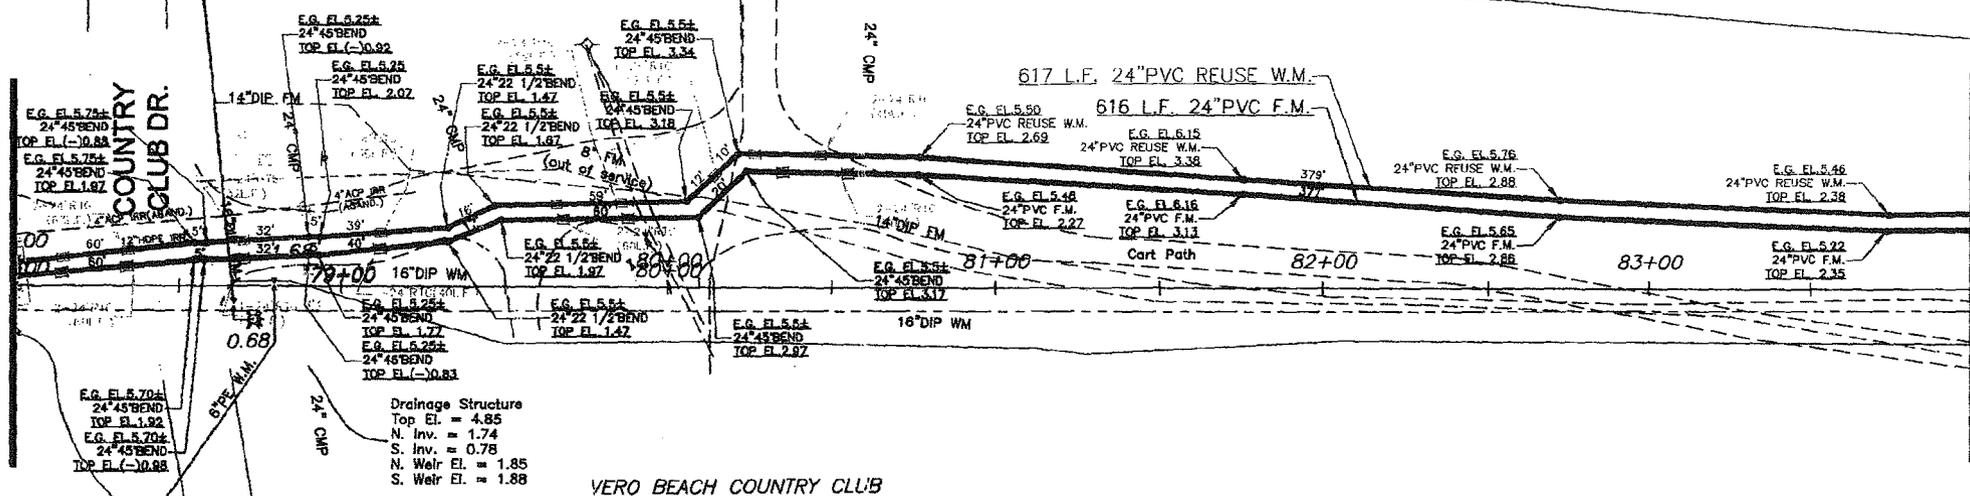

Drainage Structure
 Top El. = 4.85
 N. Inv. = 1.74
 S. Inv. = 0.78
 N. Weir El. = 1.85
 S. Weir El. = 1.88

VERO BEACH COUNTRY CLUB

| | |
|----------------|----------|
| BENCHMARK | |
| PROFILE SCALES | |
| HORIZONTAL | 1" = 20' |
| VERTICAL | 1" = 2' |

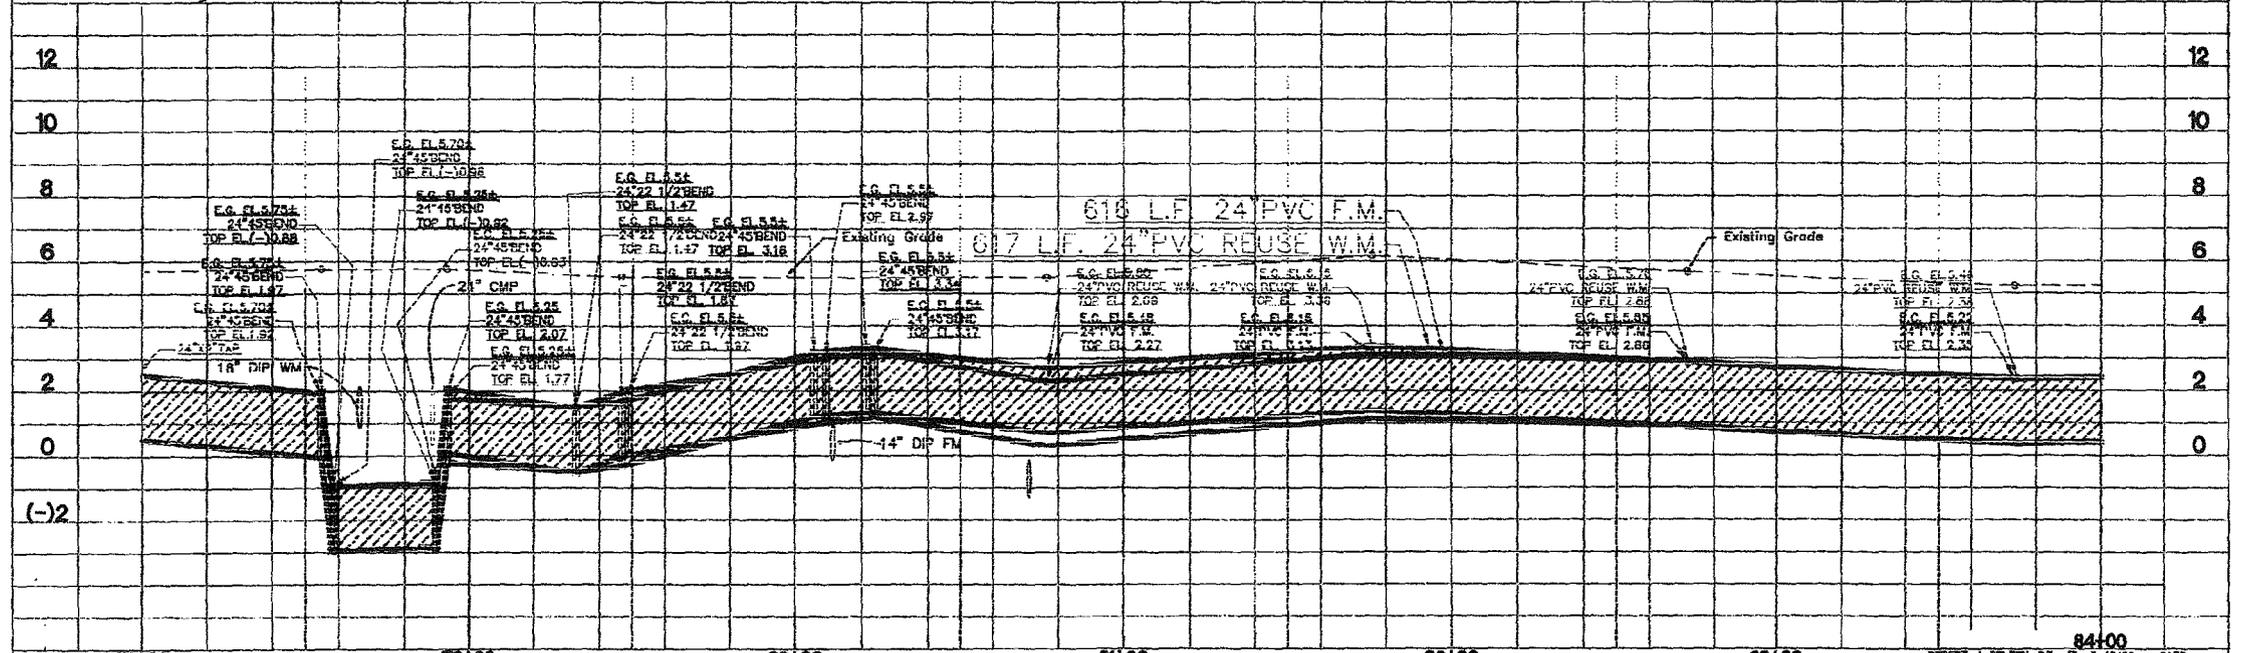

| | | | | | | |
|--|-------------|--|----------|---|-------|--|
| 78+00 | 79+00 | 80+00 | 81+00 | 82+00 | 83+00 | 84+00 |
| A AS-BUILT INFO. FIELD NOTES & SURVEY R.J.B. T.A.Y. 10/13/2010 | | FORCE MAIN FROM C.O.V.B. W.W.T.P. TO W.T.P. AS-BUILT DRAWING | | CITY OF VERO BEACH WATER AND SEWER DEPARTMENT | | PLAN & PROFILE - I.R.F.W.C.D. MAIN CANAL R.O.S. STA. 78+00 - 84+00 |
| REV. NO. | DESCRIPTION | AUTHORIZED BY | DRAWN BY | DATE | DATE | DATE |


ROBERT J. KULTON, P.E. FL # 49489 DATE 10/21/2010 CITY PROJECT

SCALE 1" = 20'

MATCH LINE

MATCH LINE


I.R.F.W.C.D. MAIN CANAL

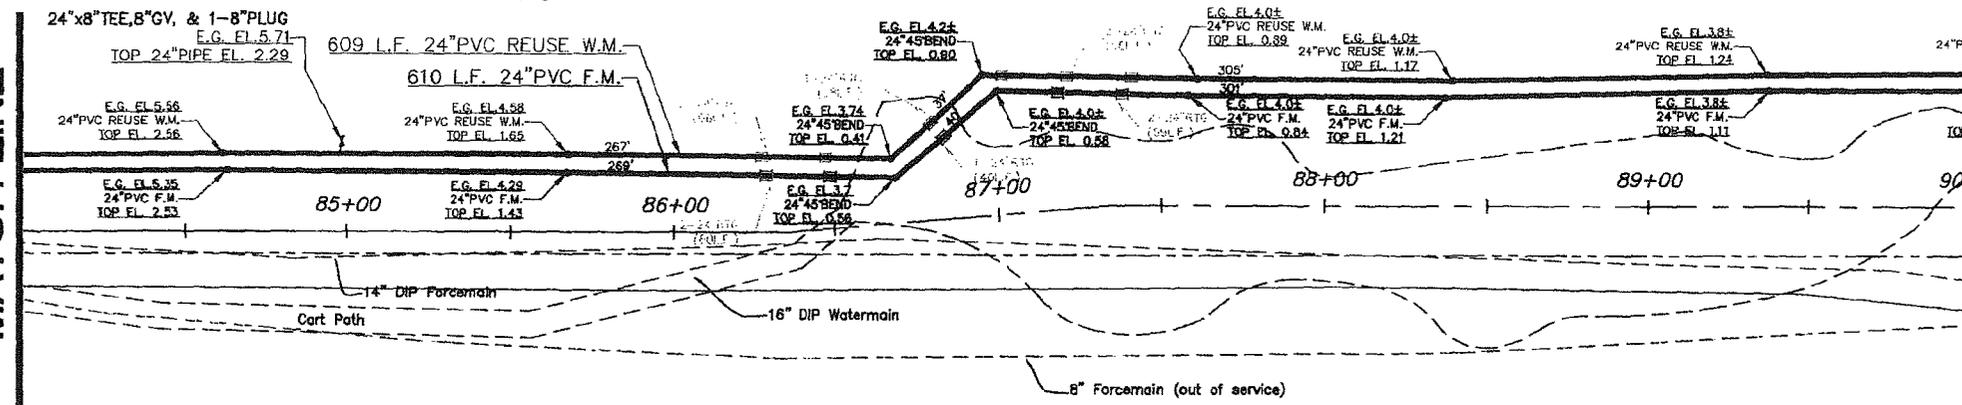

VERO BEACH COUNTRY CLUB

BENCHMARK

PROFILE SCALES
 HORIZONTAL 1" = 20'
 VERTICAL 1" = 2'

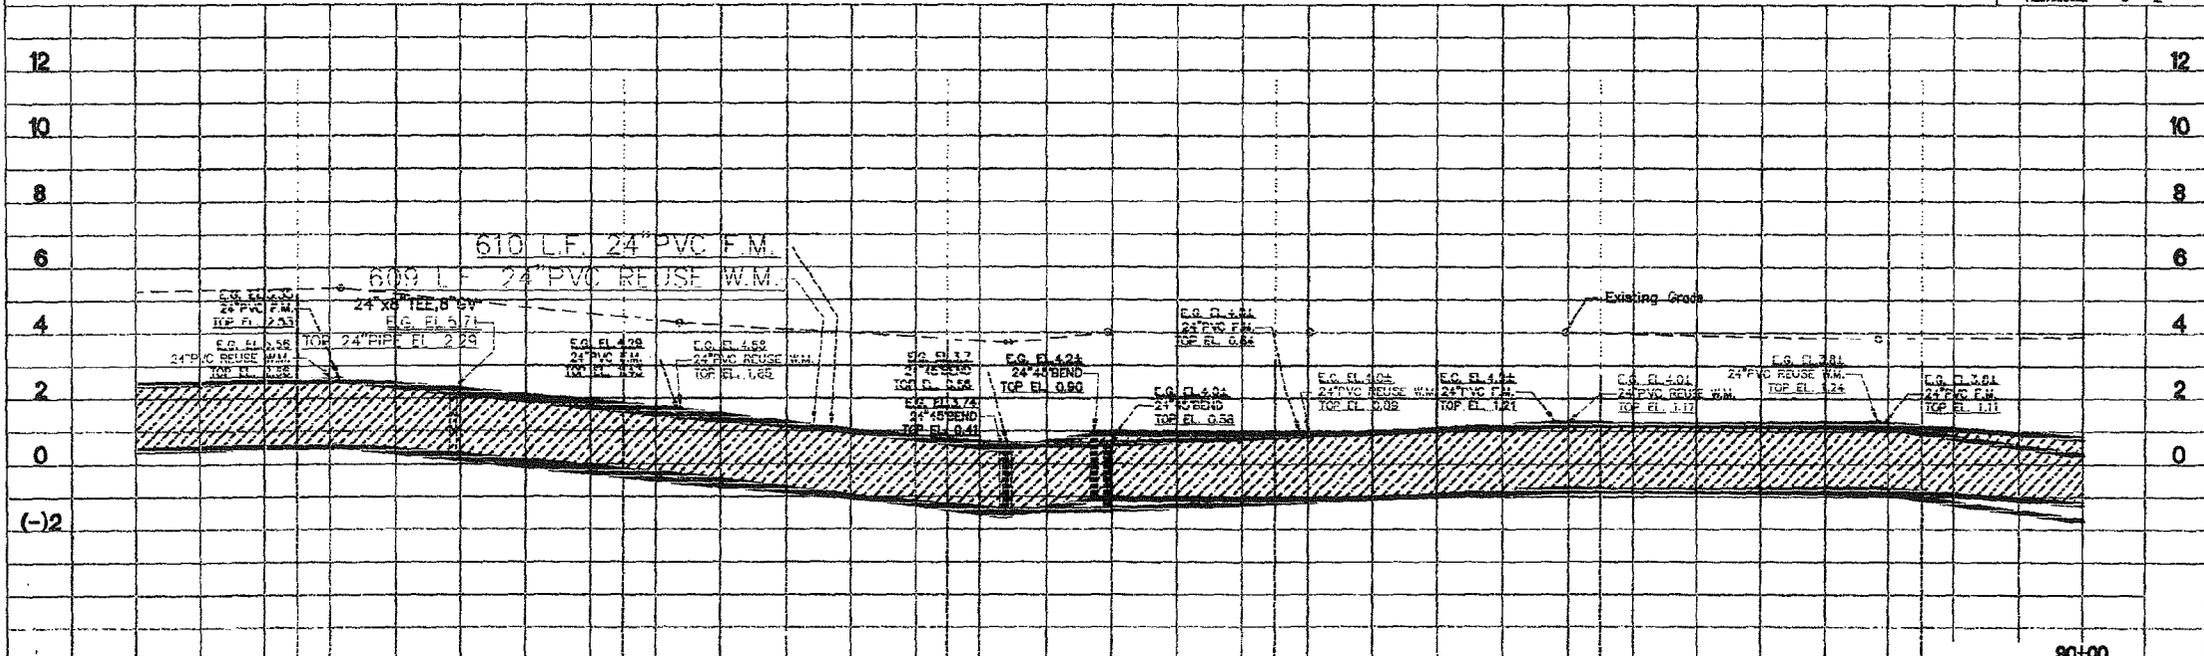


| | | | | | | |
|----------|-------------------------------------|------------|----------|------------|---|---|
| 84+00 | 85+00 | 86+00 | 87+00 | 88+00 | 89+00 | 90+00 |
| A | AS-BUILT INFO. FIELD NOTES & SURVEY | R.J.B. | T.A.Y. | 12/13/2010 | FORCE MAIN FROM C.O.V.B. W.W.T.P. TO W.T.P. | CITY OF VERO BEACH WATER AND SEWER DEPARTMENT |
| REV. NO. | DESCRIPTION | AUTHZD. BY | DRAWN BY | DATE | AS-BUILT DRAWING | PLAN & PROFILE - I.R.F.W.D. MAIN CANAL R.O. |

ROBERT J. DOLTON, P.E., FL. # 49429 DATE: 12/21/2010
 CITY PROJECT NO. WS07014 SHEET 28 OF 30


SCALE: 1" = 20'

MATCH LINE

MATCH LINE

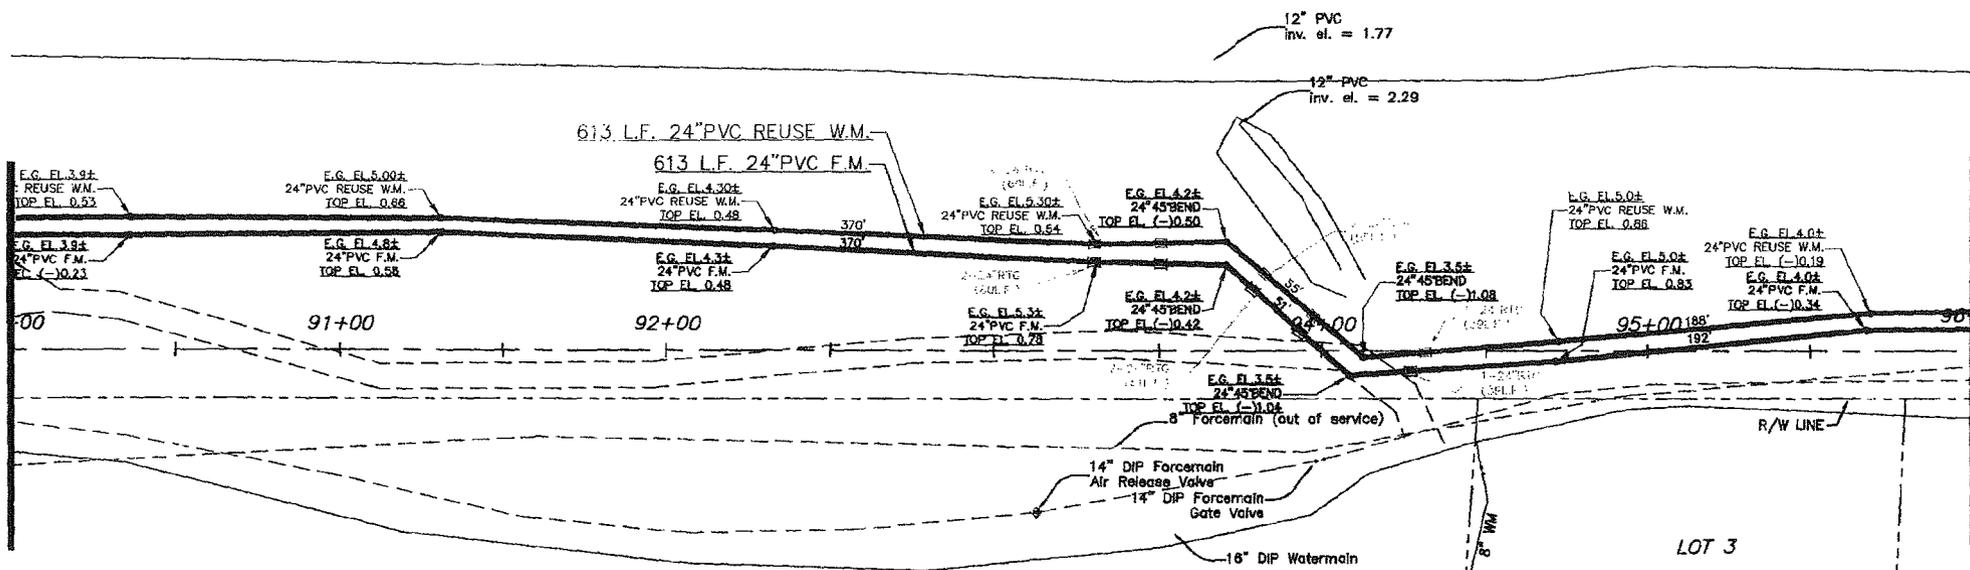

| | |
|----------------|----------|
| BENCHMARK | |
| PROFILE SCALES | |
| HORIZONTAL | 1" = 20' |
| VERTICAL | 1" = 2' |

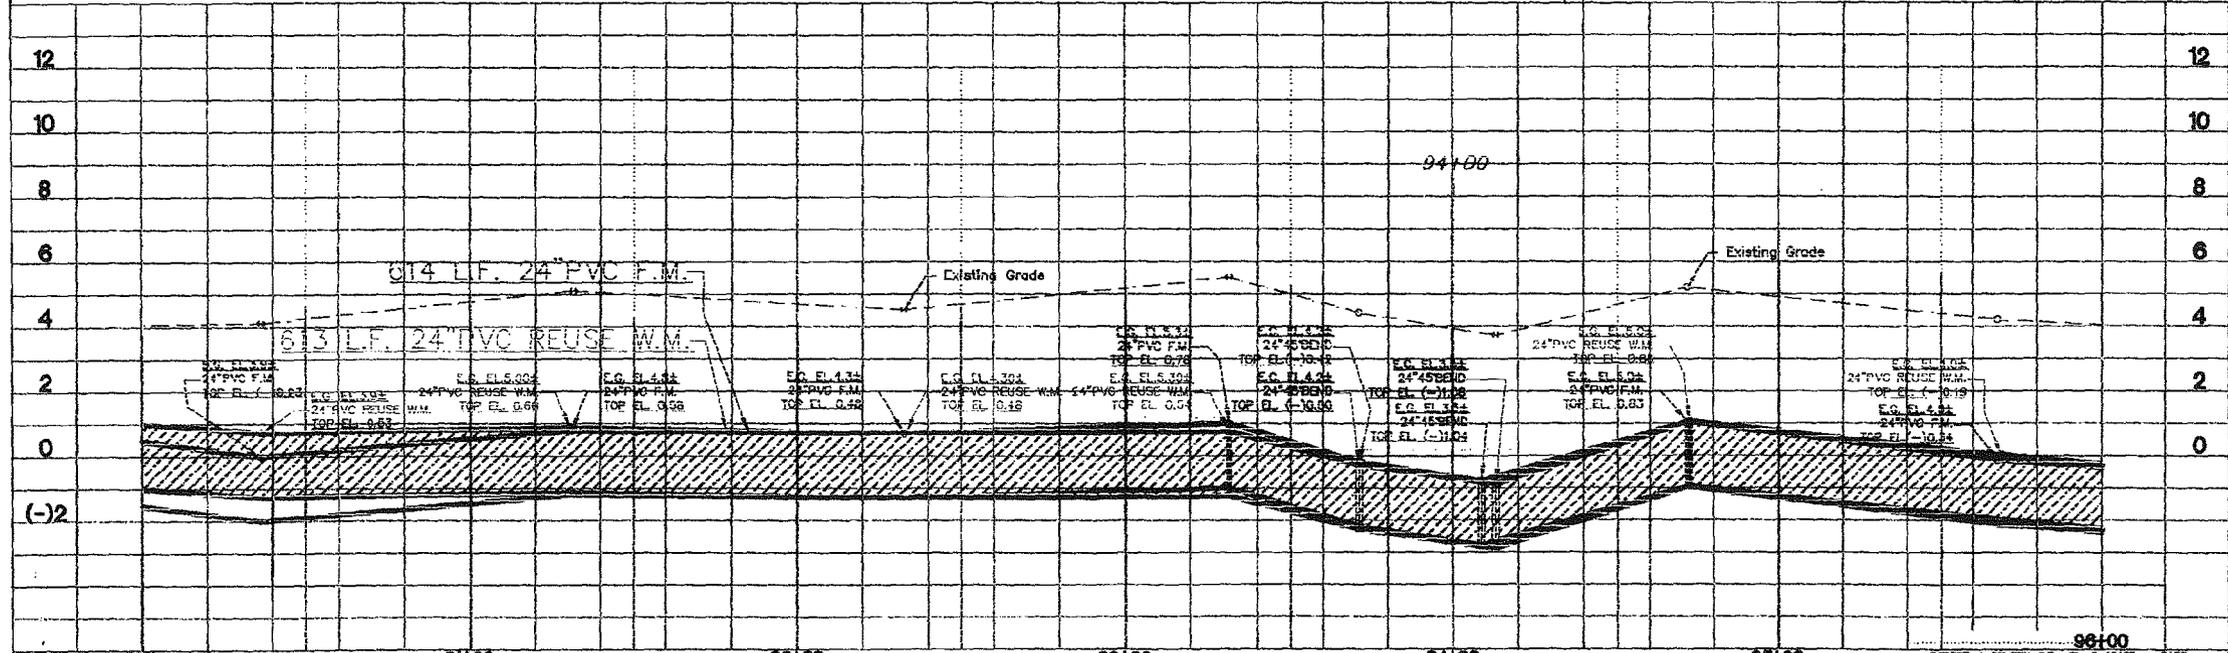

| | | | | | | |
|-------------------------------------|-------------|---|----------|--------------------|-------|---|
| 90+00 | 91+00 | 92+00 | 93+00 | 94+00 | 95+00 | 96+00 |
| AS-BUILT INFO, FIELD NOTES & SURVEY | | FORCE MAIN FROM C.O.V.B. W.W.T.P. TO W.T.P. | | CITY OF VERO BEACH | | PLAN & PROFILE - I.R.F.W.D. MAIN CANAL R.O.W. |
| REV. NO. | DESCRIPTION | AUTHORIZED BY | DRAWN BY | DATE | DATE | DATE |


ROBERT J. NELSON, P.E. FL # 49429 DATE 1/21/2010 CITY PROJECT 144 WSC7014

SCALE: 1" = 20'


MATCH LINE
SHEET 16 OF 30

I.R.F.W.C.D. MAIN CANAL

MATCH LINE

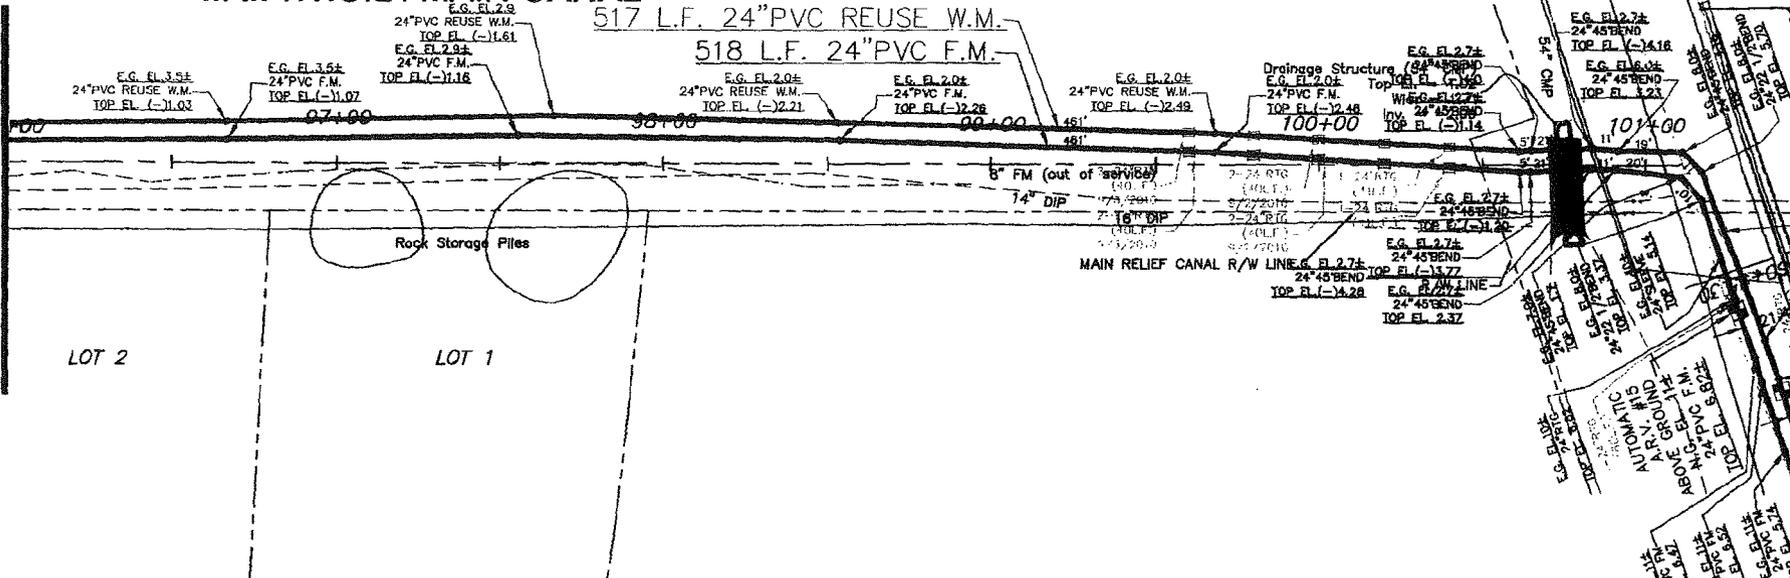

PROFILE SCALES
HORIZONTAL 1" = 20'
VERTICAL 1" = 2'

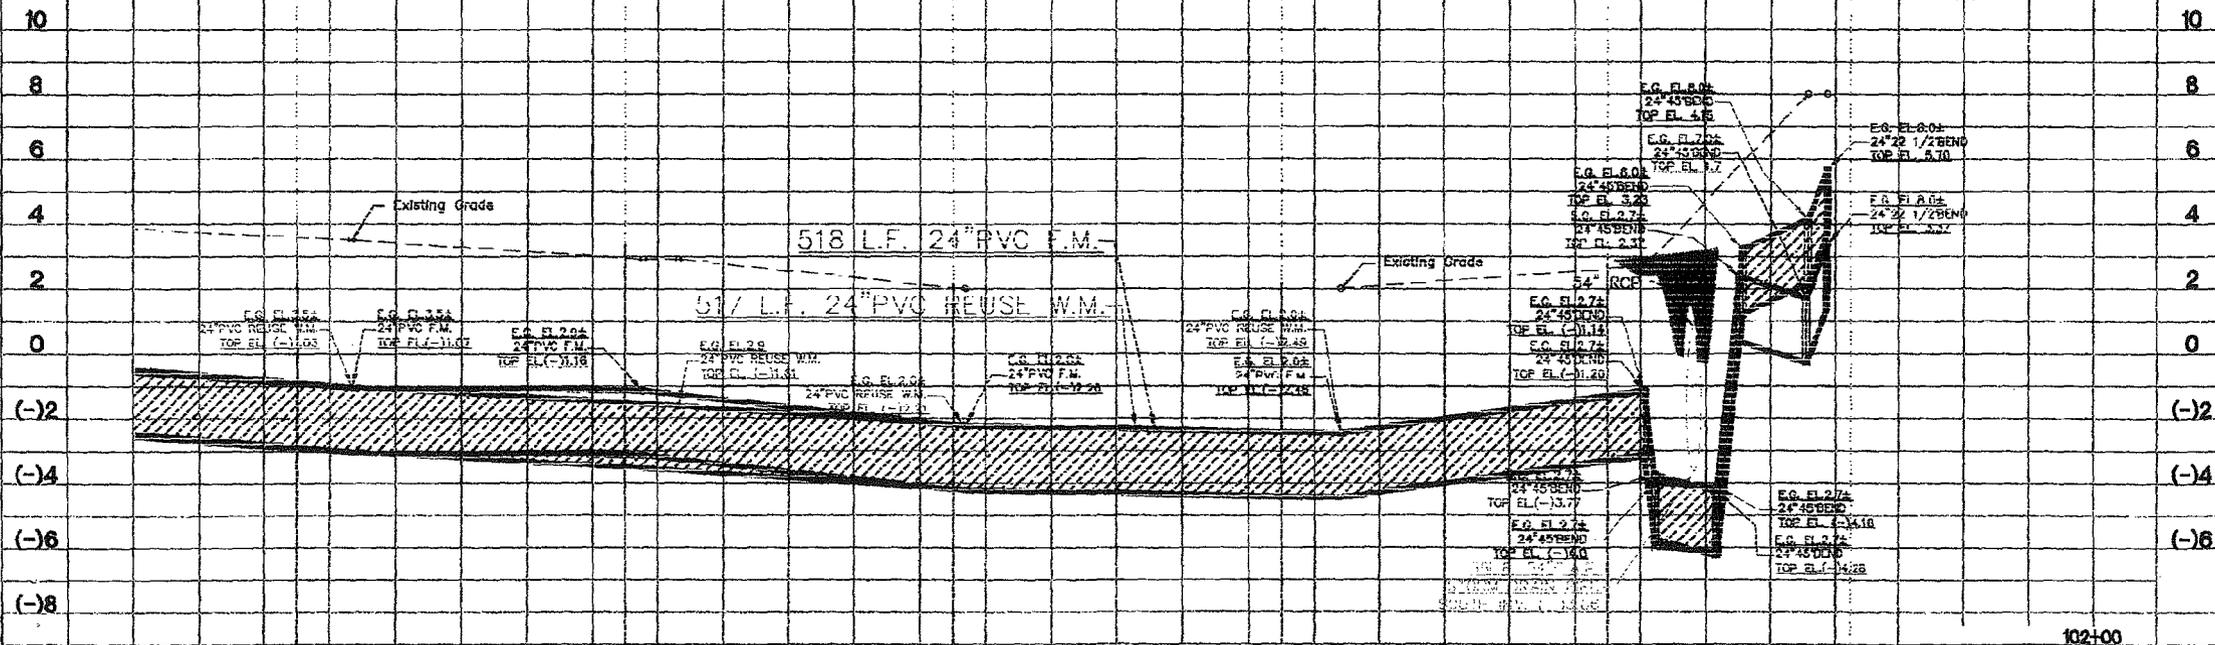

| | | | | | | |
|-------------------------------------|-------------|---|----------|--------------------|--------|---|
| 96+00 | 97+00 | 98+00 | 99+00 | 100+00 | 101+00 | 102+00 |
| AS-BUILT INFO, FIELD NOTES & SURVEY | | FORCE MAIN FROM C.O.V.B. W.W.T.P. TO W.T.P. | | CITY OF VERO BEACH | | PLAN & PROFILE - I.R.F.W.C.D. MAIN CANAL R.O.W. |
| REV. NO. | DESCRIPTION | AUTHORZD. BY | DRAWN BY | DATE | DATE | DATE |

ROBERT J. BELTON, P.E. FL # 49489
DATE: 8/13/2010
CITY PROJECT

PERMIT AND INTERLOCAL AGREEMENT

(No. VB-8)

THIS PERMIT and INTERLOCAL AGREEMENT, dated as of the 1st day of January, 2016, by and between **INDIAN RIVER FARMS WATER CONTROL DISTRICT**, a drainage district organized and existing under the General Drainage Laws of the State of Florida, whose address is 7305 4th Street, Vero Beach, Florida, hereinafter referred to as the "District", and the **CITY OF VERO BEACH**, a municipal corporation of the State of Florida, hereinafter referred to as the "Permittee".

NOW, THEREFORE, the District does hereby grant unto the Permittee a permit for a period of one year from January 1, 2016, unless sooner terminated as hereinafter provided, to maintain, inspect, operate and repair a 14" diameter sanitary sewer force main on, over and across District right-of-way of the Main Canal at Country Club Drive, for a distance of approximately 1,511 lineal feet at the locations and in accordance with the plans and specifications attached hereto and marked "Exhibit A" and signed by the parties and, by reference, made a part hereof, together with the right of ingress and egress on and over the property at said locations; provided, however, that as a condition precedent to the right herein granted, Permittee agrees to and with the District as follows:

1. That the construction and installation of force main has been in exact conformity with the as-built plans prepared by Robert J. Bolton, P.E., City of Vero Beach Water & Sewer Department.

2. That the rights shall extend only for force main used exclusively by the City of Vero Beach (unless otherwise agreed to by District) and belonging to the Permittee and the Permittee shall not have any right to assign or sublet this Permit or any part thereof unto a third part.

3. Permittee assumes full responsibility for the operation and maintenance of said force main and shall save and hold harmless District from any expense, loss, damage or claim in regard thereto, and the District assumes and shall have no liability in connection therewith.

4. That this Permit is subject always to the paramount right of the District to keep and maintain its drainage district functions and operations, and is subject to revocation and cancellation upon thirty days' notice from District to the City and Permittee.

5.. In no event shall the District be liable for any damages done or caused by the District to the public, to Permittee or any other person, using right-of-way or property subject to this Permit, and Permittee shall save the District, its officers, agents, supervisors, and employees harmless from any costs, charge or expense or claim or demand of any person against the District, to the extent permitted by law and subject to the limits provided by Section 768.28, Florida Statutes, arising from or pertaining to any use by Permittee made of the property or structures subject to this Permit. Permittee shall, as a condition to the effectiveness of this Permit, provide to District evidence satisfactory to District, of adequate commercial general liability insurance providing all risks coverage which protects Permittee and the District, its officers, agents, supervisors, and employees from any and all claims and liabilities for bodily injury and property

damage arising from Permittee operations of its use of the District right-of-way or property subject to this permit. Coverage shall be provided in a form no more restrictive than the latest edition of the commercial general liability policy filed by the Insurance Service Office. Policies shall be endorsed to name District as an additional insured and shall include provisions for at least thirty (30) days advance notice to District by the insurer prior to any policy change, amendment, termination, or expiration of coverage. Permittee shall direct its insurance agent to provide District with a policy, an additional insured endorsement containing language no less restrictive than ISO Form CG 20 10 07 04 or ISO Form CG 20 33 07 04, and a certificate of insurance. This Permit shall be null and void if adequate insurance is not maintained by the Permittee.

6. The District may, on thirty days' written notice to the Permittee, require cessation of use within District's right-of-way, together with removal or alteration of any installation or construction on District right-of-way.

7. The Permittee shall at all times maintain cable markers above ground at 100 foot intervals to show the location of any underground objects. The force main shall be constructed and installed to permit the crossing of heavy equipment used by the District for the maintenance of its laterals, sub-laterals and canals and for any similar heavy equipment used by land owners within the District. In any case where the force main crosses a pipe or culvert used for drainage or irrigation purposes, or a pipe or culvert is needed hereafter for drainage or irrigation of adjacent lands, and the same is deemed by District or an adjacent landowner to be required to be installed, repaired or replaced, then upon twenty-four (24) hours notice, Permittee shall, at Permittee's sole cost and expense, be available at the location of, and arrange for such installation, repair or replacement with personnel and equipment to insure that the force main does not endanger or prevent the installation, repair, replacement or use of pipes or culverts for drainage or irrigation purposes. The District has the right to determine the exact location of the force main within the said right-of-way in order that the location of same shall not interfere with the District's functions and operations and of the District land owners.

8. Permittee shall advise District's office prior to commencement or completion of all construction.

9. Permittee shall not discharge any pollutants, contaminants or deleterious materials into waters or structures owned or maintained by, or subject to the jurisdiction of District, nor permit anything to obstruct the flow of water, and shall save and hold District harmless from an expense, loss or damage to District or others by any such discharge or obstruction, remedying or removing the same immediately upon request by District.

10. This Permit shall exist only so long as Permittee may be in full compliance with all requirements of the Department of Environmental Protection for the State of Florida, as such requirements relate to this project, and if, at any time, the Permittee shall fail to meet such requirements, then this Permit shall, ipso facto, immediately become null and void.

11. Permittee, as a condition to the continuance of this Permit, shall reimburse District, immediately on demand, for any fees for testing or other professional services, costs or expenses to District associated with or arising from Permittee's use of District right-of-way.

12. The Permittee shall pay to the District an annual rent of Four Hundred Eighty Six and 50/100 Dollars (\$486.50), payable in advance. In addition to the permit fee payable hereunder, if the permit applied for or the use for which the permit is granted requires engineering or legal work for purposes of processing and approval by District, then Permittee shall pay promptly when invoiced all engineering and legal fees incurred by District in connection herewith and shall indemnify District for the same, saving and holding District harmless from any liability in connection therewith.

13. This Permit shall be effective January 1, 2016, and continue for a period of one year unless sooner terminated as provided herein.

14. In the event that this Permit is canceled or terminated, the Permittee shall, at its expense, promptly remove the sewer force main from the right-of-way of the District.

15. This Permit shall be considered to be a license only, for the limited purpose of installation, placement and maintenance of the improvements specified on the face hereof, and does not convey any other right, title or interest of the District in the subject right-of-way property.

16. In the event of any dispute arising hereunder, the parties agree that, as a condition precedent to litigation, the parties shall first submit the same to non-binding mediation with a Florida Circuit Court certified civil mediator with the cost of such mediation shared equally between the parties.

17. Permittee assumes full responsibility for any construction, operation or maintenance on District property or right-of-way subject to the Permit and understands and agrees that Permittee's use of District property for Permittee's purposes and benefit is at Permittee's sole risk; any loss or damage to Permittee's property, installations, facilities or personnel while on District property or right-of-way, regardless of the cause of the same, including, without limitation, negligence or want or care on the part of District, its agents or employees, whether by reason of the provision of Chapter 556, Florida Statutes, or otherwise, is Permittee's and not District's (except as may be otherwise provided by Section 768.28, Florida Statutes) and, as a condition of this Permit, Permittee promises, covenants and agrees that neither Permittee, nor anyone claiming by, through or under Permittee, shall have any claim or cause of action against District by reason of such loss or damage. The parties hereto further acknowledge and agree that District has no obligation to allow Permittee to enter upon or use District's property or right-of-way, and does so only in consideration of Permittee's release of District from any responsibility or liability whatsoever, including for damage caused by District's negligence, now or in the future, and Permittee agrees that it is able, at its own expense, to insure against loss or damage, without granting any right of subrogation to claims against District or Permittee.

18. This Permit may not be assigned or sublet to a third party and any transfer of Permittee's property abutting District's property or right-of-way shall, ipso facto and without more, cancel, nullify and revoke this Permit.

19. Permittee understands, acknowledges and agrees that the business of District is digging within the area of its rights of way and sole responsibility for damage to any facilities, structures or property located underground is Permittee's and not the District's.

20. In consideration of the grant of this Permit, Permittee, if a public or private body with the power of eminent domain, expressly waives and relinquishes power of eminent domain or condemnation of the property as to which this Permit applies for the use for which the Permit is granted. This clause shall survive termination or expiration of this Permit.

IN WITNESS WHEREOF, said District has caused these present to be executed in its name by its Secretary and its corporate seal hereto affixed, by due authority of its Board of Supervisors, this ____ day of _____, 2016.

Signed, sealed and delivered
in the presence of:

as to District

(SEAL)

**INDIAN RIVER FARMS WATER
CONTROL DISTRICT**

By: _____
David E. Gunter, Secretary

Permittee hereby accepts the terms of this Permit, and covenants and agrees that it will comply with the terms and condition of this Permit.

Dated this ____ day of _____, 2016.

Signed, sealed and delivered
in the presence of:

as to Permittee

CITY OF VERO BEACH

By: _____
Mayor

Attest: _____
City Clerk

(SEAL)

| CITY OF VERO BEACH | APPROVED | DATE |
|-----------------------|------------|----------------|
| City Manager | | |
| City Attorney | <i>WRC</i> | <i>1/12/16</i> |
| City Clerk | | |
| Utilities - <i>WS</i> | <i>RJB</i> | <i>1/12/16</i> |
| Public Works | | |
| Finance | | |
| Human Resources | | |
| Planning | | |
| | | |
| | | |

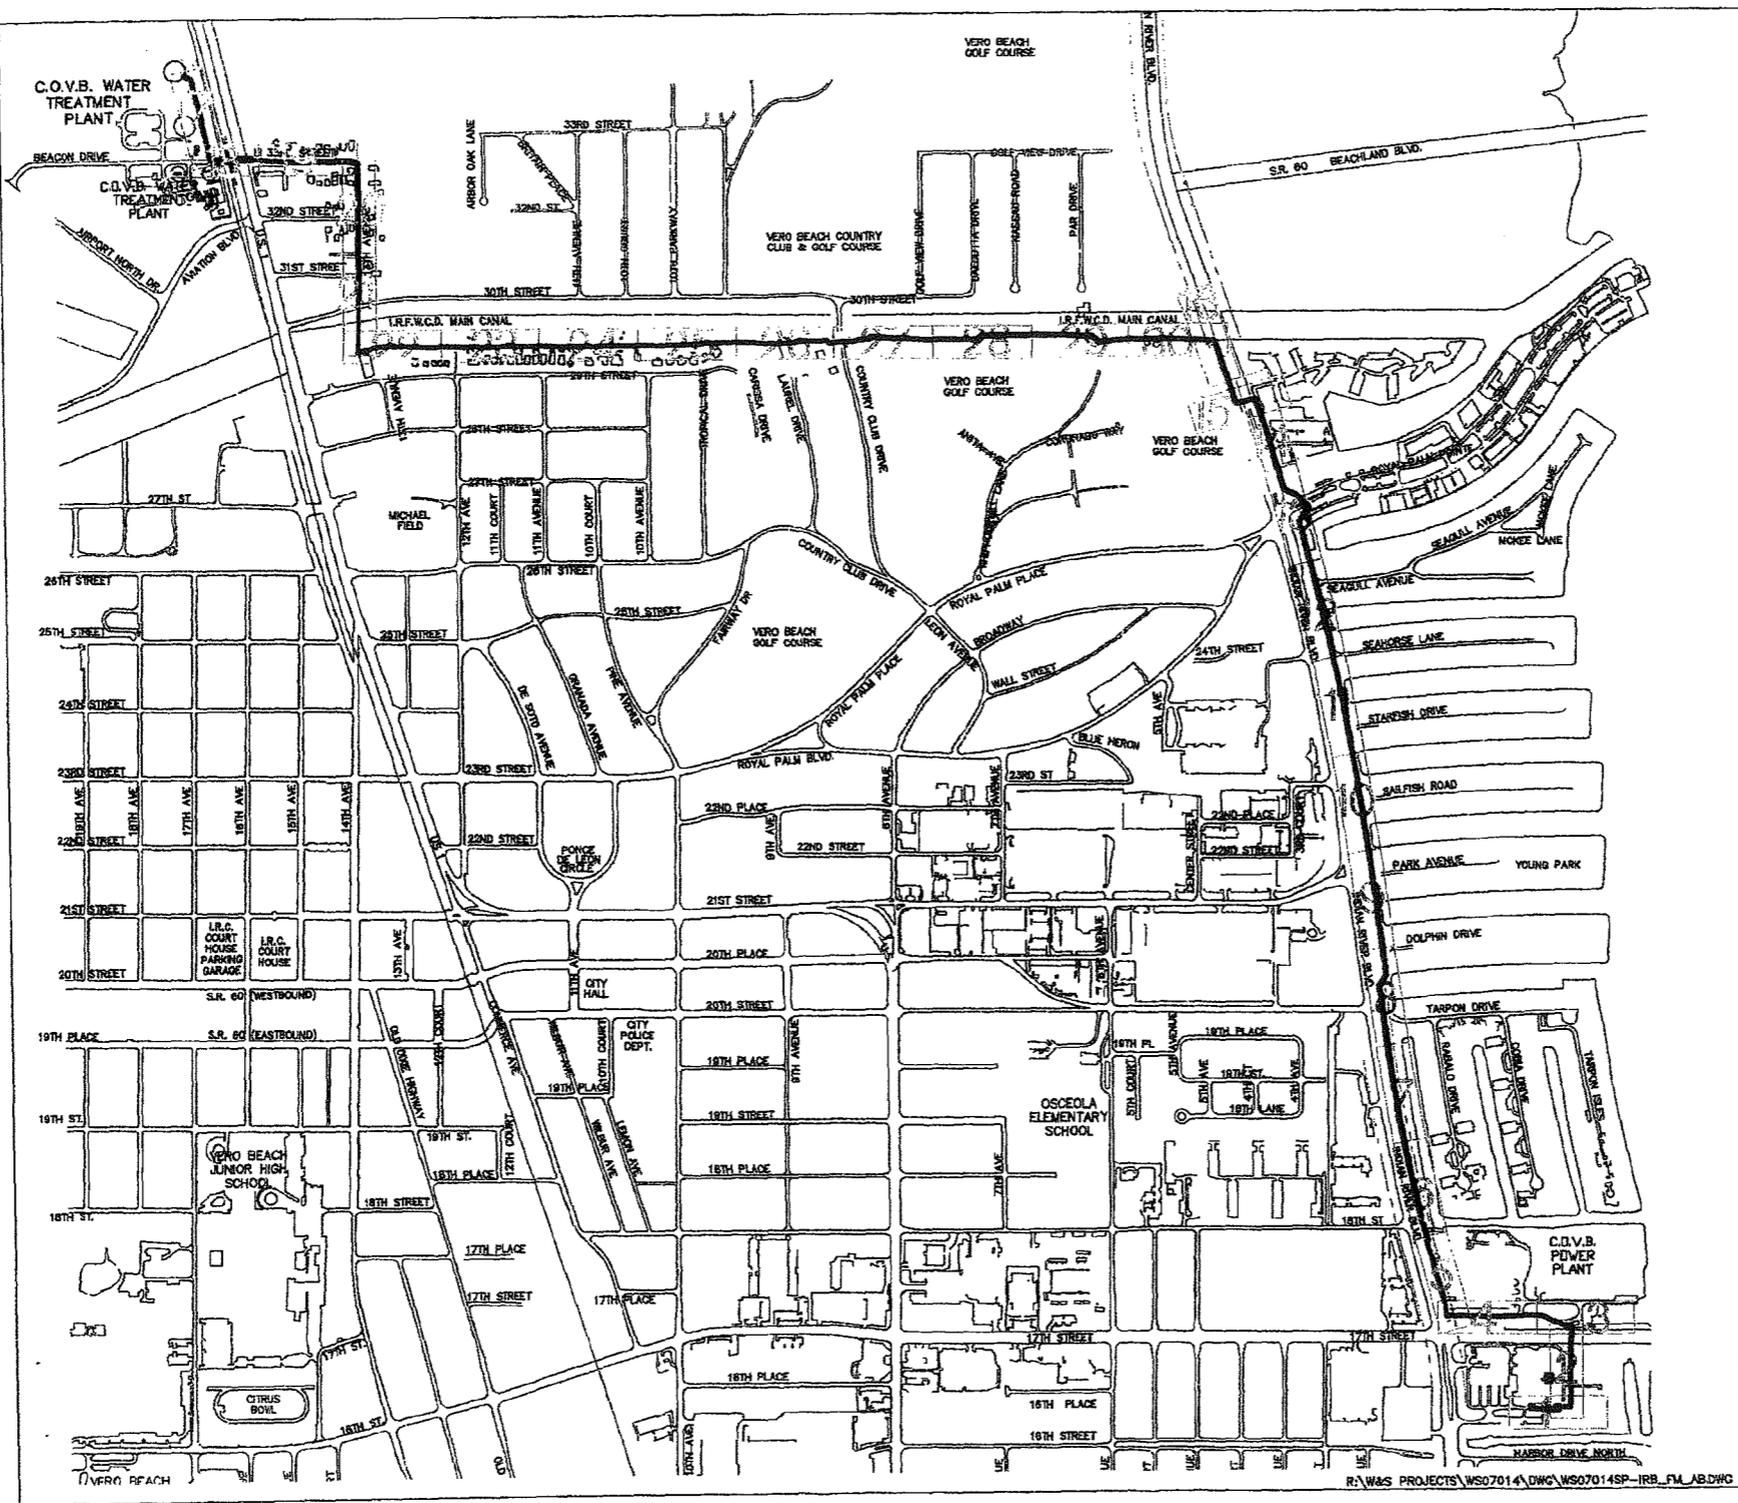



EXHIBIT "A"
(11 pages)

- LEGEND**
- AS-BUILT SHEET NO. 30
 - 24" PVC FM
 - 24" HDPE FM
 - 24" PVC REUSE WM



PLOT DATE: 10/05/2010

| REV. NO. | DESCRIPTION | AUTHORIZED BY | DATE |
|--|--|-----------------|-----------------|
| | FORCE MAIN FROM C.O.V.B. W.W.T.P. TO W.T.P. AS-BUILT DRAWING | | |
| | SHEET LAYOUT | SCALE: 1" = 20' | DATE: 7/17/2010 |
| CITY OF VERO BEACH WATER AND SEWER DEPARTMENT | | | |
| CITY PROJECT NO. WSO7014 | | SHEET 1 OF 1 | |

Handwritten signature
ROBERT J. GILTON, P.E.
DATE: 10/5/10

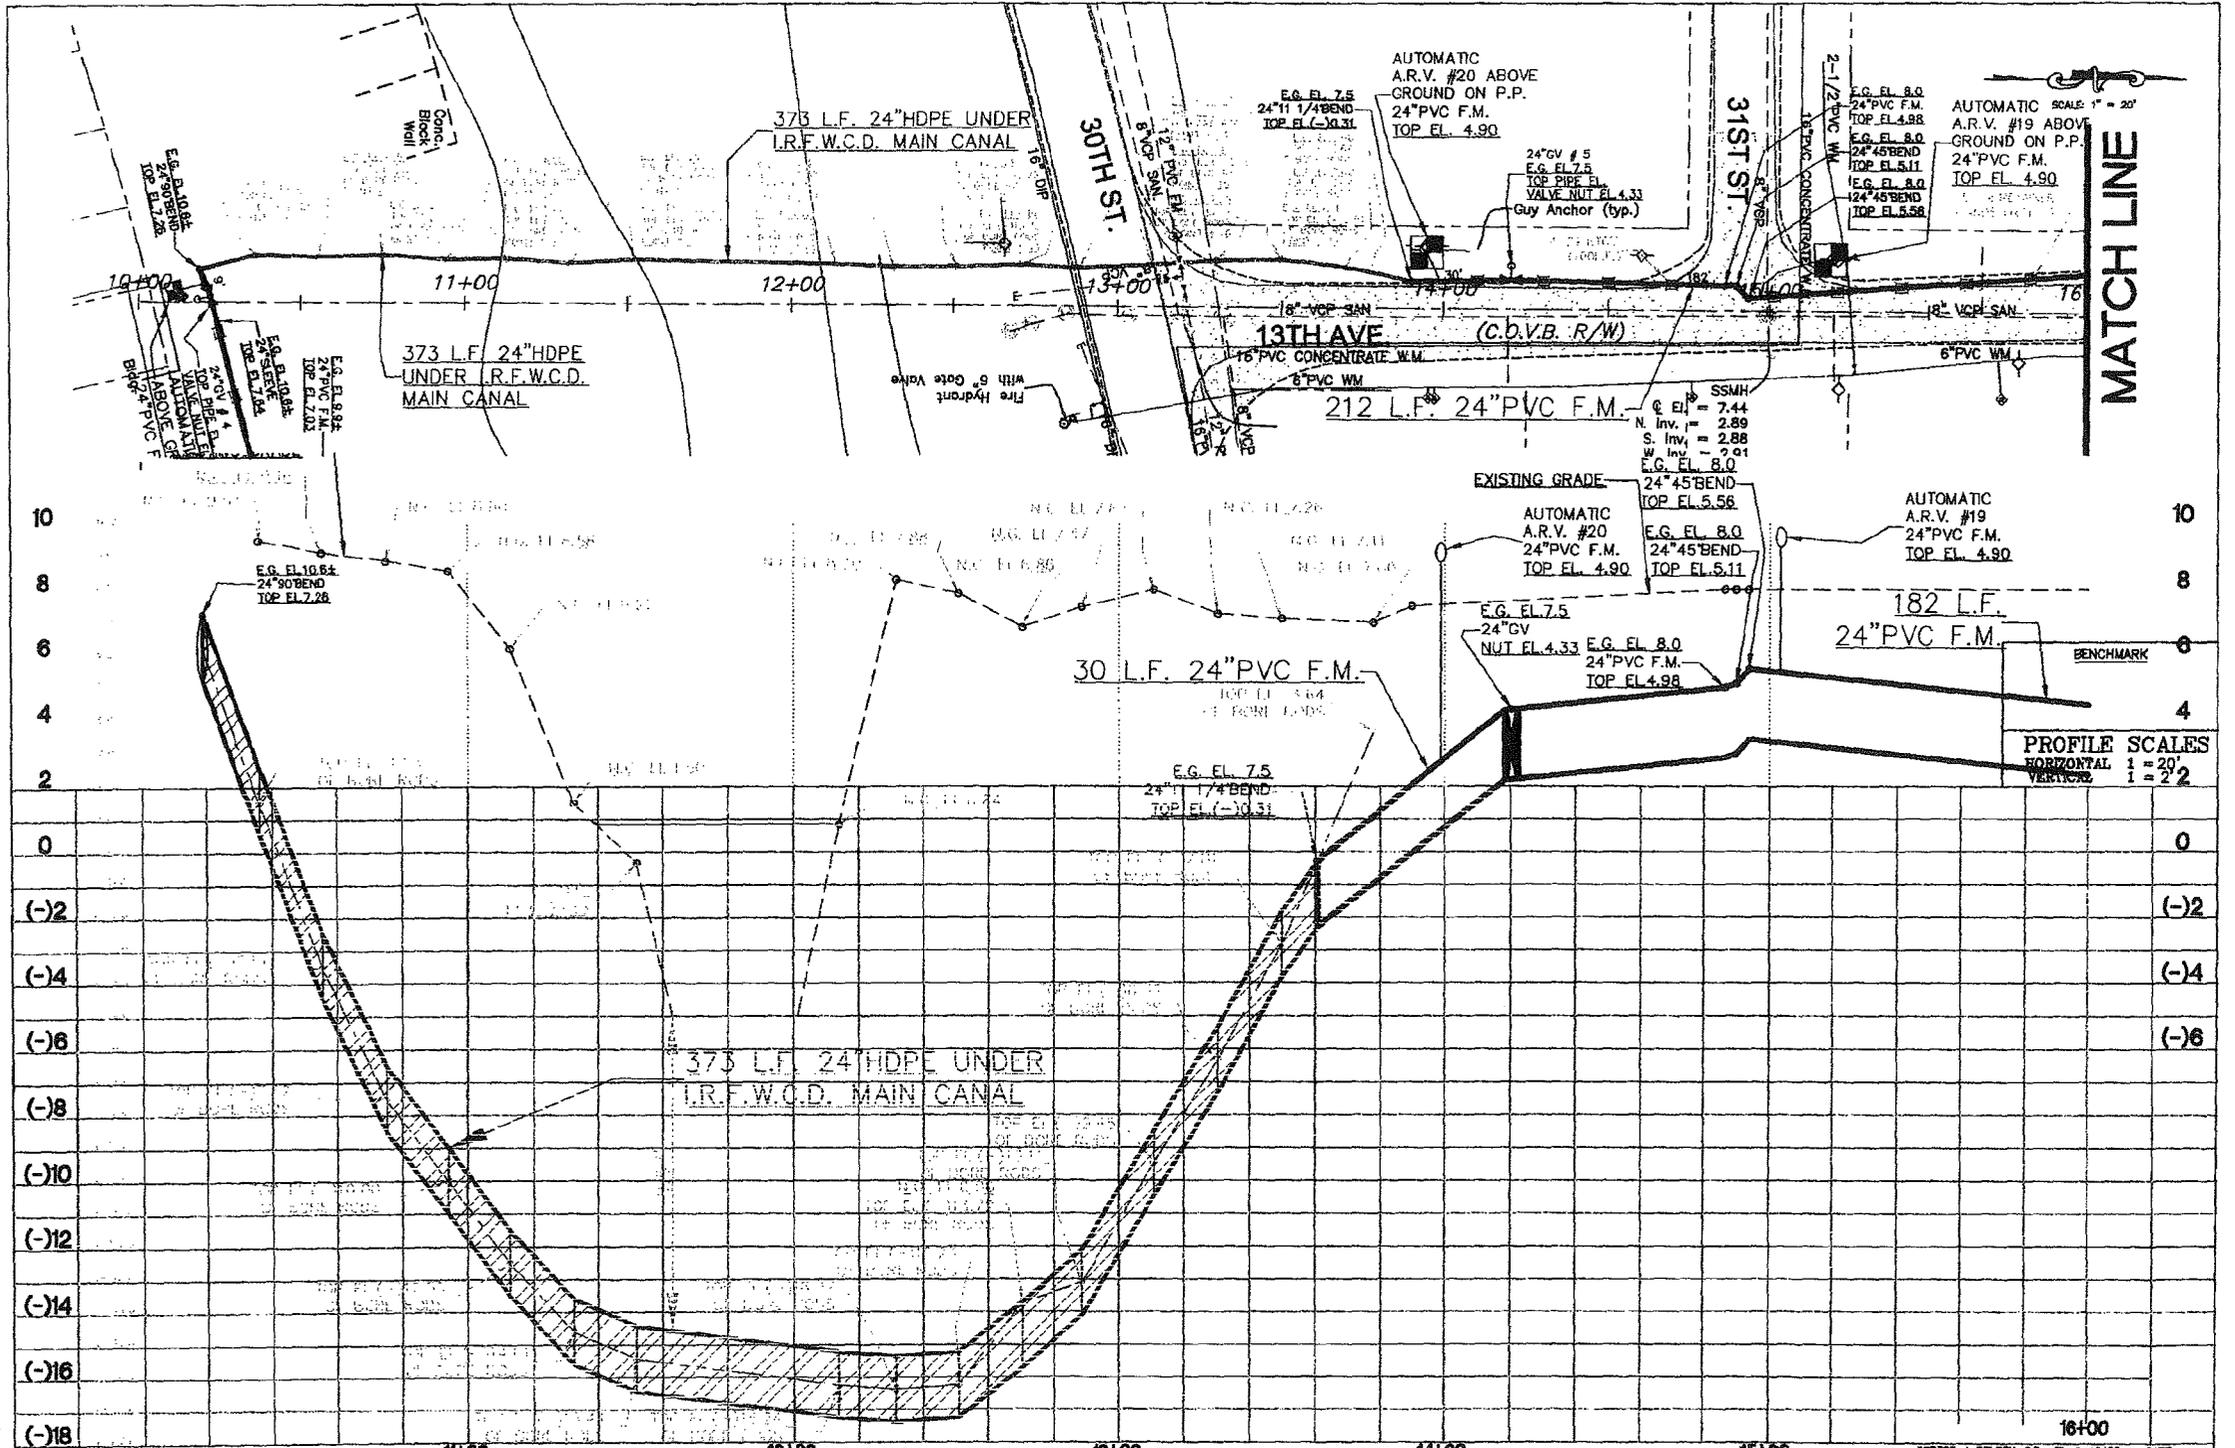


| | | | | | | | | |
|----------|-------------------------------------|---------------|----------|-----------|---|----------------------------|------------------------------------|------------------------------------|
| 10+00 | 11+00 | 12+00 | 13+00 | 14+00 | 15+00 | 16+00 | ROBERT J. BELTON, P.E. FL. # 49429 | DATE |
| A | AS-BUILT INFO. FIELD NOTES & SURVEY | R.J.B. | T.A.Y. | 8/13/2010 | FORCE MAIN FROM C.O.V.B. W.W.T.P. TO W.T.P. | | CITY OF VERO BEACH | PLAN & PROFILE - C.O.V.B. W.W.T.P. |
| REV. NO. | DESCRIPTION | AUTHORIZED BY | DRAWN BY | DATE | AS-BUILT DRAWING | WATER AND SEWER DEPARTMENT | STA. 10+00 - 16+00 | CITY PROJECT |
| | | | | | | | | NO. WS07014 |

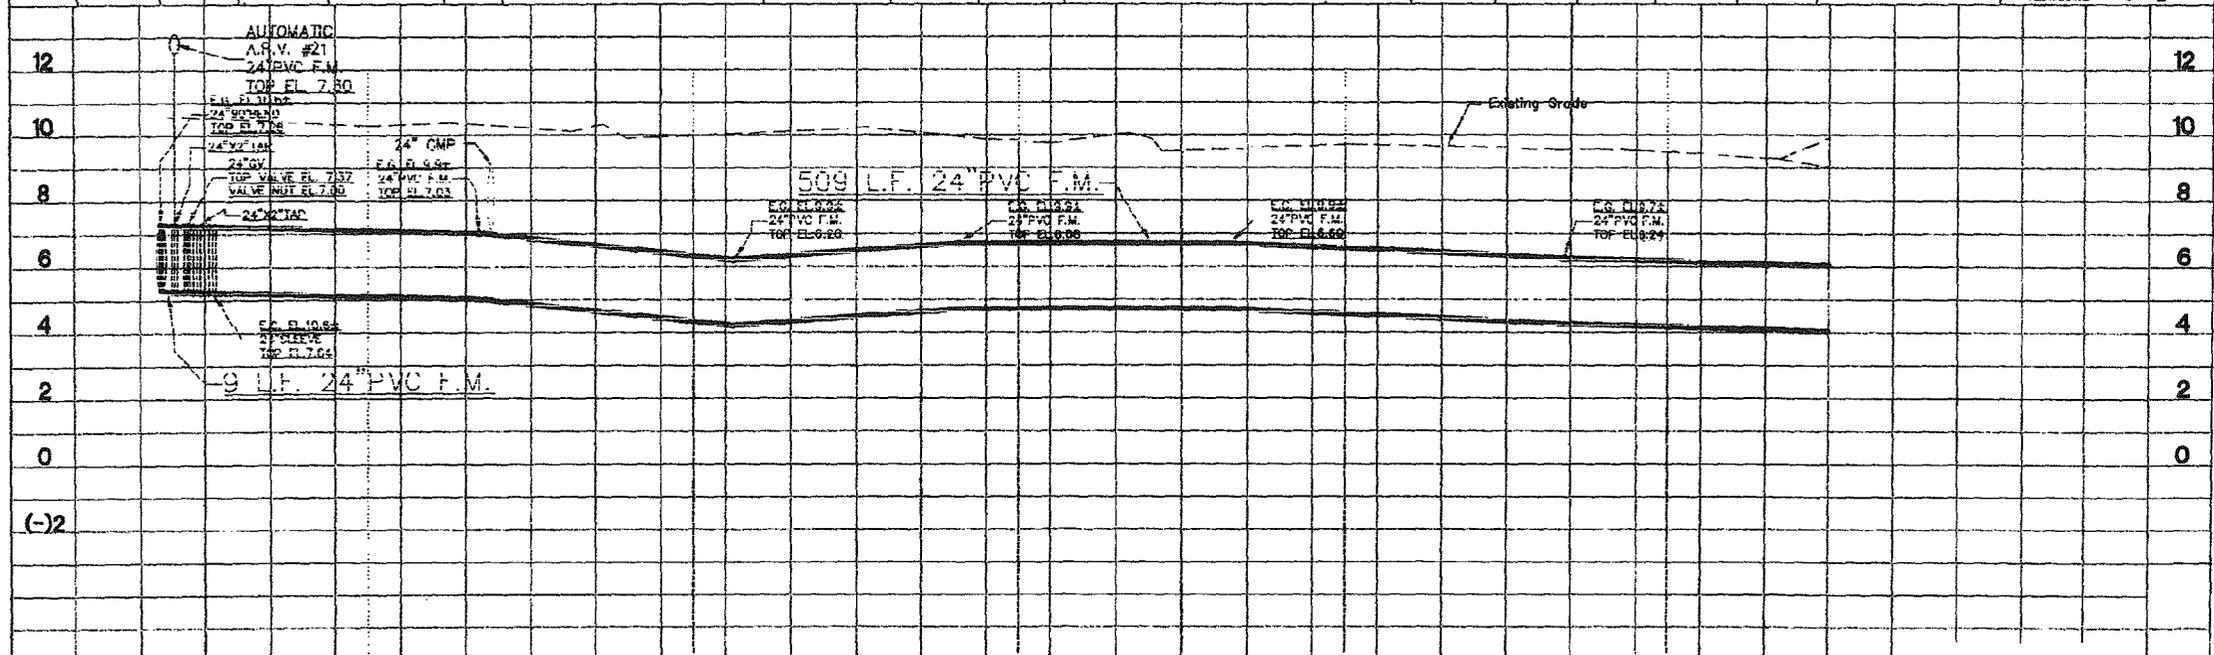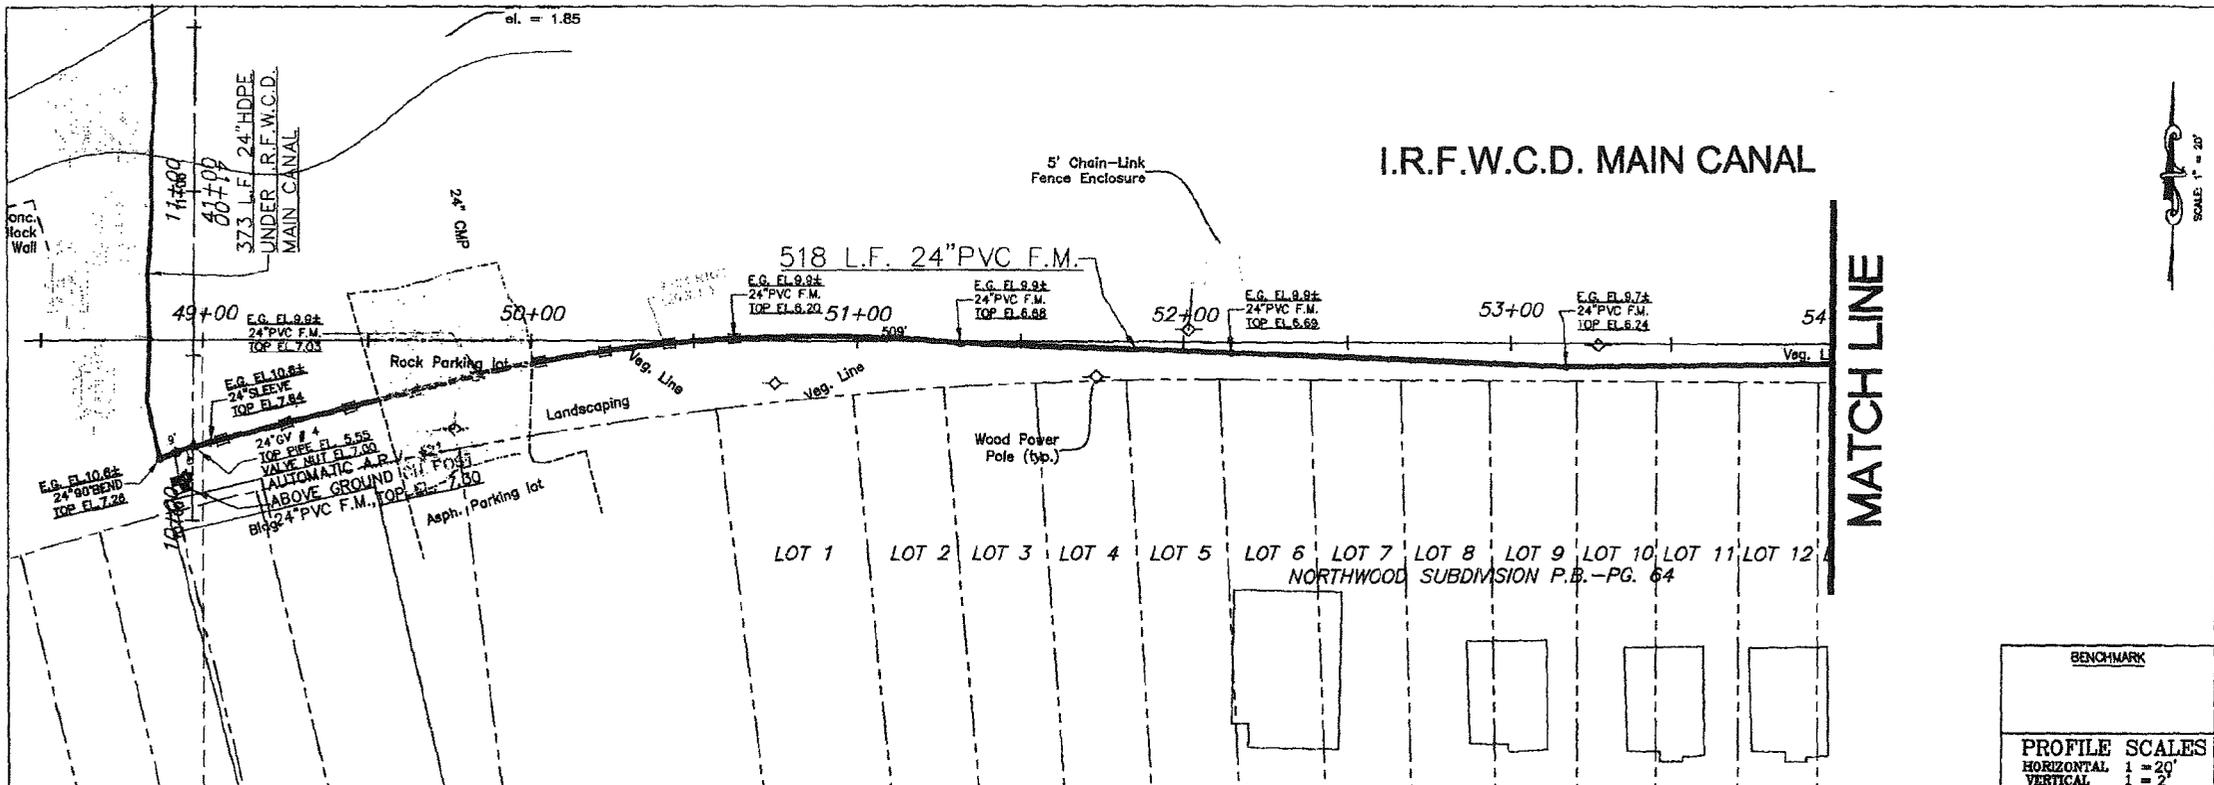

| | | | | | | | |
|---|-------|-------|----------------------------|-------|-------|---|-------|
| 49+00 | 50+00 | 51+00 | 52+00 | 53+00 | 54+00 | ROBERT J. HOLTEN, P.E. # 49489 | DATE: |
| AS-BUILT INFO. FIELD NOTES & SURVEY | | | CITY OF VERO BEACH | | | PLAN & PROFILE - I.R.F.W.D. MAIN CANAL R.O. | |
| AS-BUILT DRAWING | | | WATER AND SEWER DEPARTMENT | | | 12/22/10 | |
| FORCE MAIN FROM C.O.V.B. W.W.T.P. TO W.T.P. | | | STA. 49+00 - 54+00 | | | CITY PROJECT NO. WS07014 | |
| REV. NO. DESCRIPTION | | | AUTHZD. BY | | | DRAWN BY DATE | |

| | |
|----------------|----------|
| BENCHMARK | |
| PROFILE SCALES | |
| HORIZONTAL | 1" = 20' |
| VERTICAL | 1" = 2' |




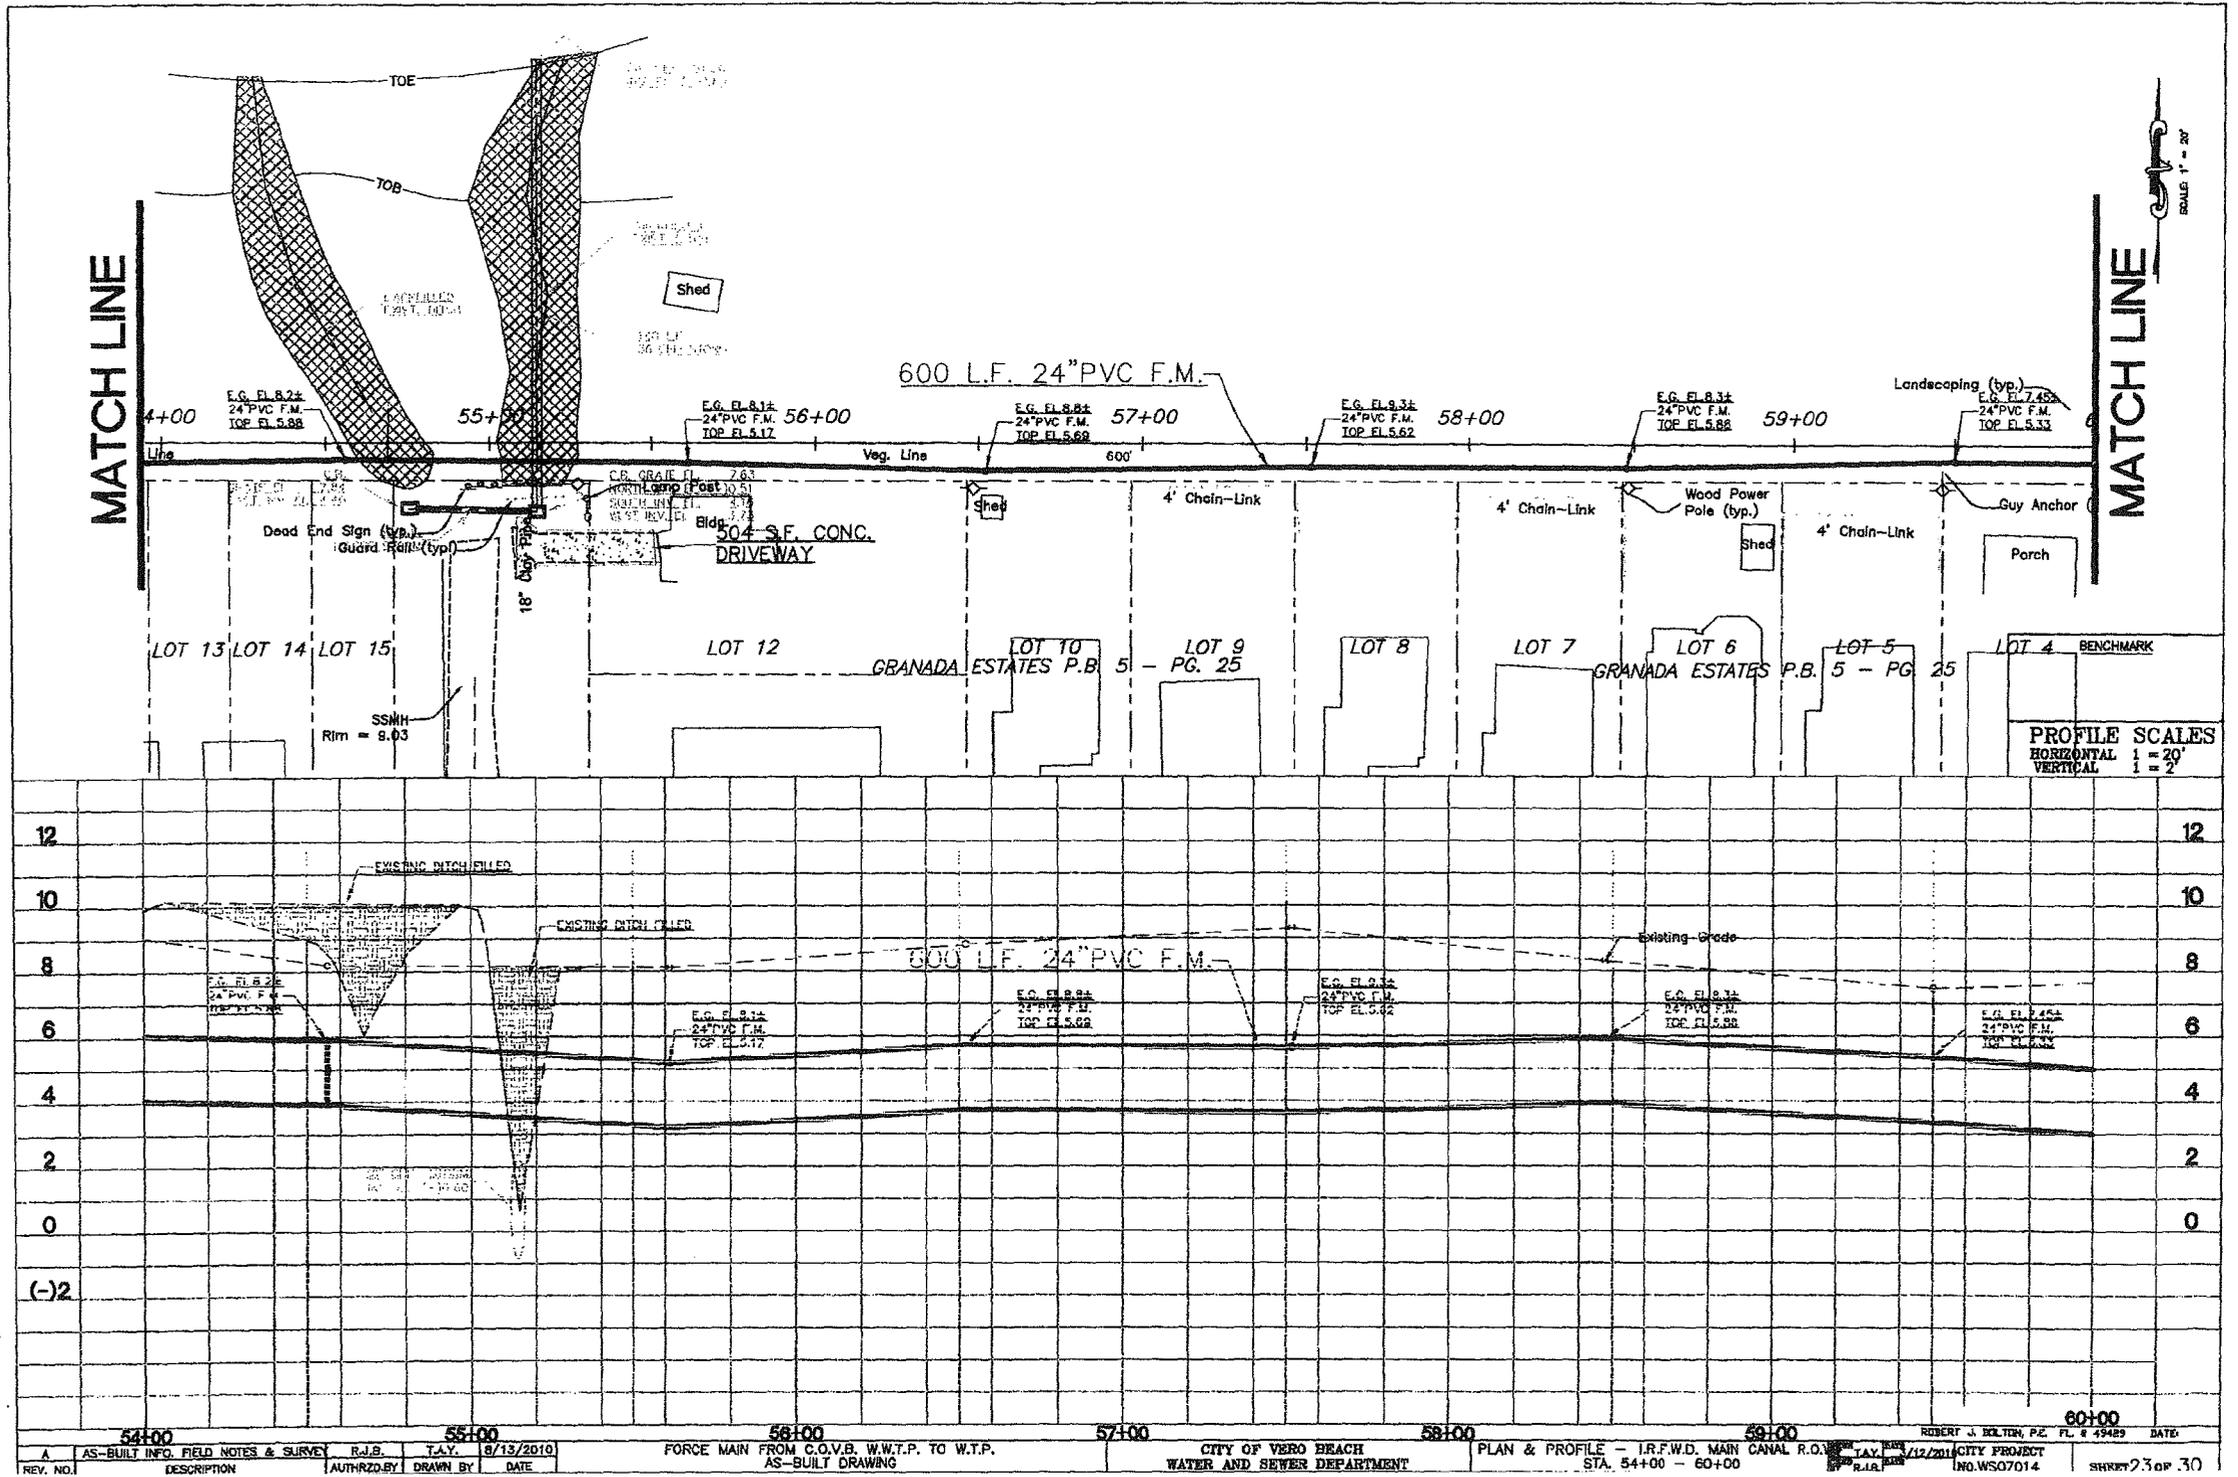

| | | | | | | | | | | | | | | | |
|----------|-------------|--------------|----------|------|--|---|--|-------------|-----------------|------------------|--------------|-----------------|-------------|-----------------|--------------|
| REV. NO. | DESCRIPTION | AUTHORZD. BY | DRAWN BY | DATE | FORCE MAIN FROM C.O.V.B. W.W.T.P. TO W.T.P. AS-BUILT DRAWING | CITY OF VERO BEACH WATER AND SEWER DEPARTMENT | PLAN & PROFILE - I.R.F.W.D. MAIN CANAL R.O. STA. 54+00 - 60+00 | NO. WS07014 | DATE: 11/2/2010 | DESIGNER: R.J.B. | CITY PROJECT | DATE: 11/2/2010 | NO. WS07014 | DATE: 11/2/2010 | SHR 23 OF 30 |
|----------|-------------|--------------|----------|------|--|---|--|-------------|-----------------|------------------|--------------|-----------------|-------------|-----------------|--------------|

SCALE: 1" = 20'



PROFILE SCALES
HORIZONTAL 1" = 20'
VERTICAL 1" = 2'

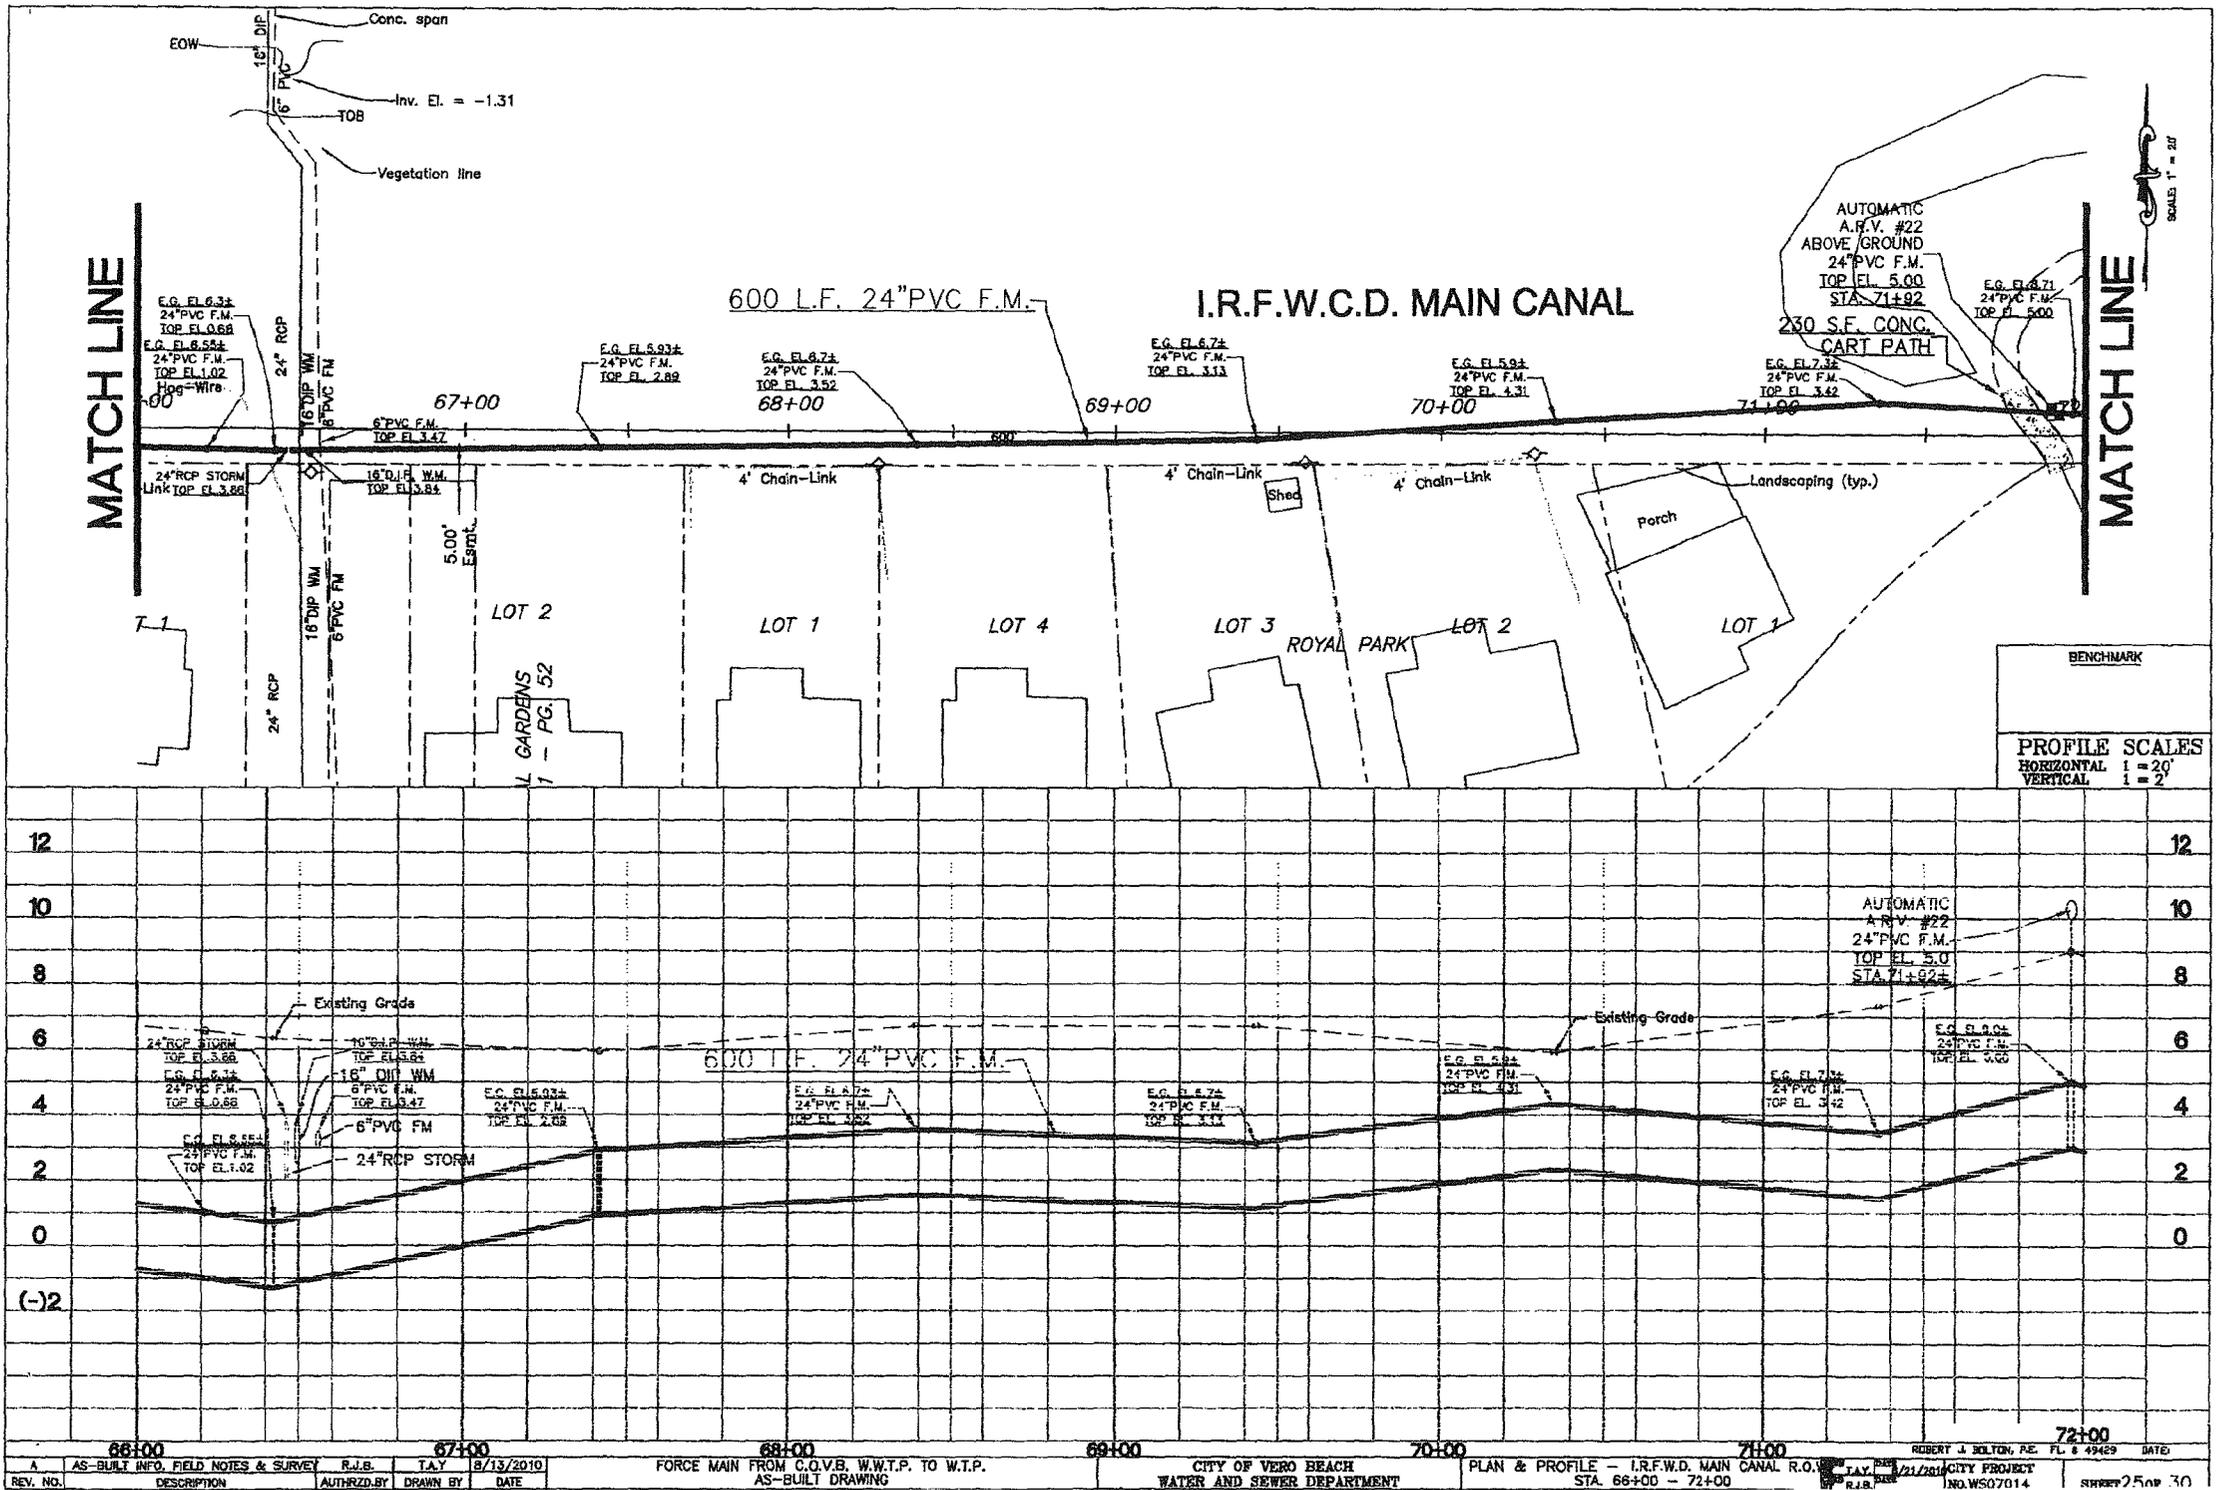



| | | | | | | |
|---|-------|-------|---|-------|-------|-------|
| 66+00 | 67+00 | 68+00 | 69+00 | 70+00 | 71+00 | 72+00 |
| AS-BUILT INFO. FIELD NOTES & SURVEY | | | FORCE MAIN FROM C.O.V.B. W.W.T.P. TO W.T.P. | | | |
| AS-BUILT DRAWING | | | CITY OF VERO BEACH WATER AND SEWER DEPARTMENT | | | |
| PLAN & PROFILE - I.R.F.W.D. MAIN CANAL R.O. | | | CITY PROJECT NO. WS07014 | | | |
| DATE: 8/13/2010 | | | DATE: 8/21/2010 | | | |
| DRAWN BY: T.A.Y. | | | DRAWN BY: T.A.Y. | | | |
| AUTHZD. BY: R.L.B. | | | AUTHZD. BY: R.L.B. | | | |
| REV. NO. | | | REV. NO. | | | |
| DESCRIPTION | | | DESCRIPTION | | | |

ROBERT J. BOLTON, P.E. FL # 49429 DATE: 8/21/2010



SHEET 25 OF 30

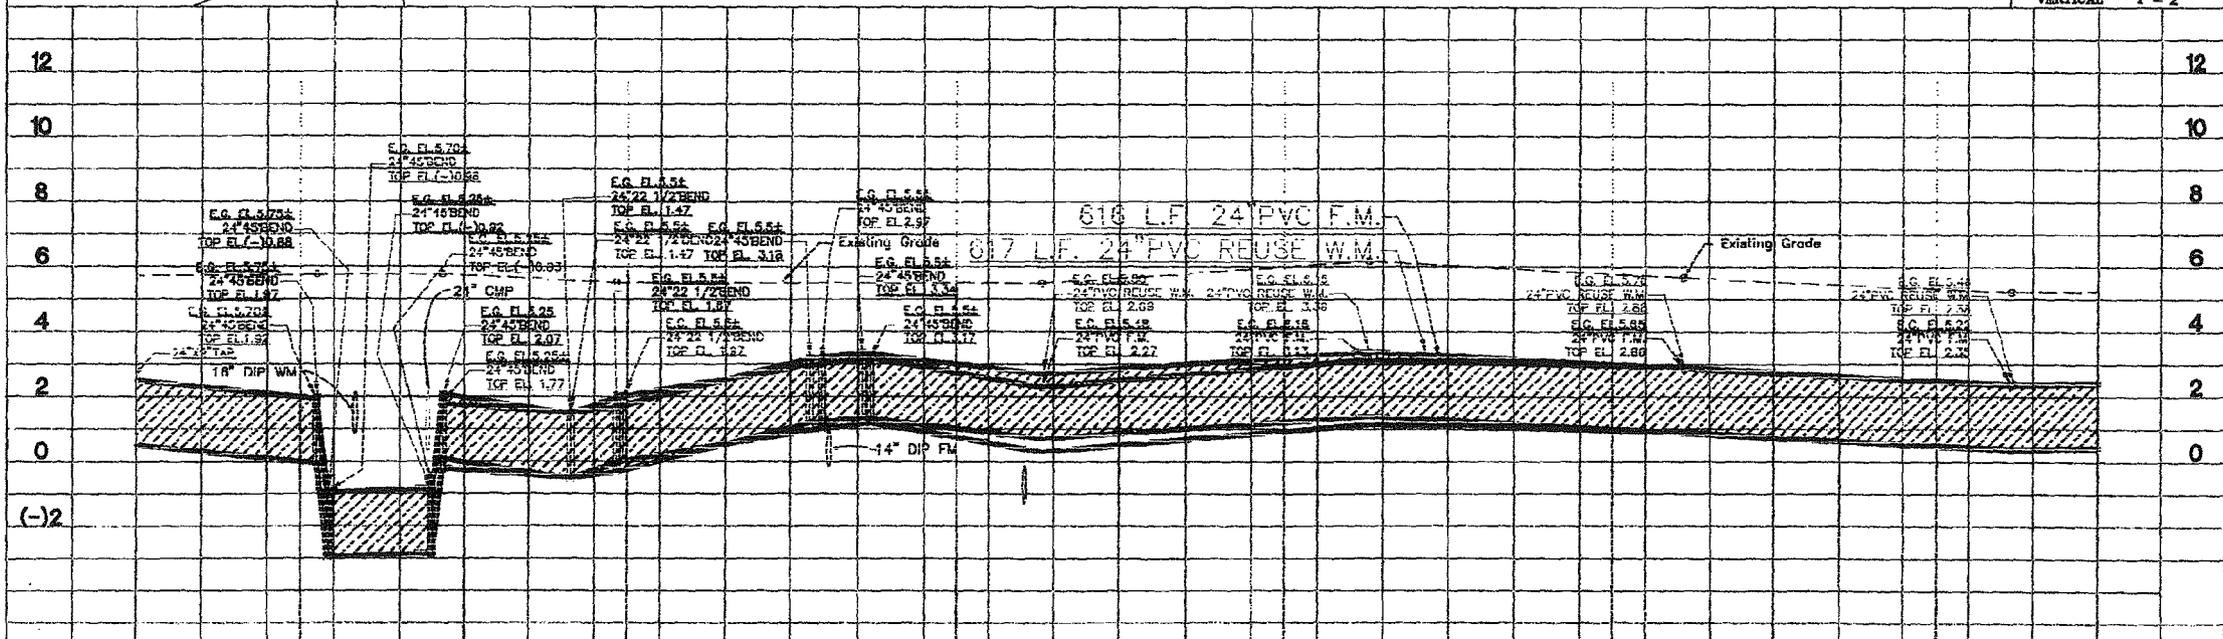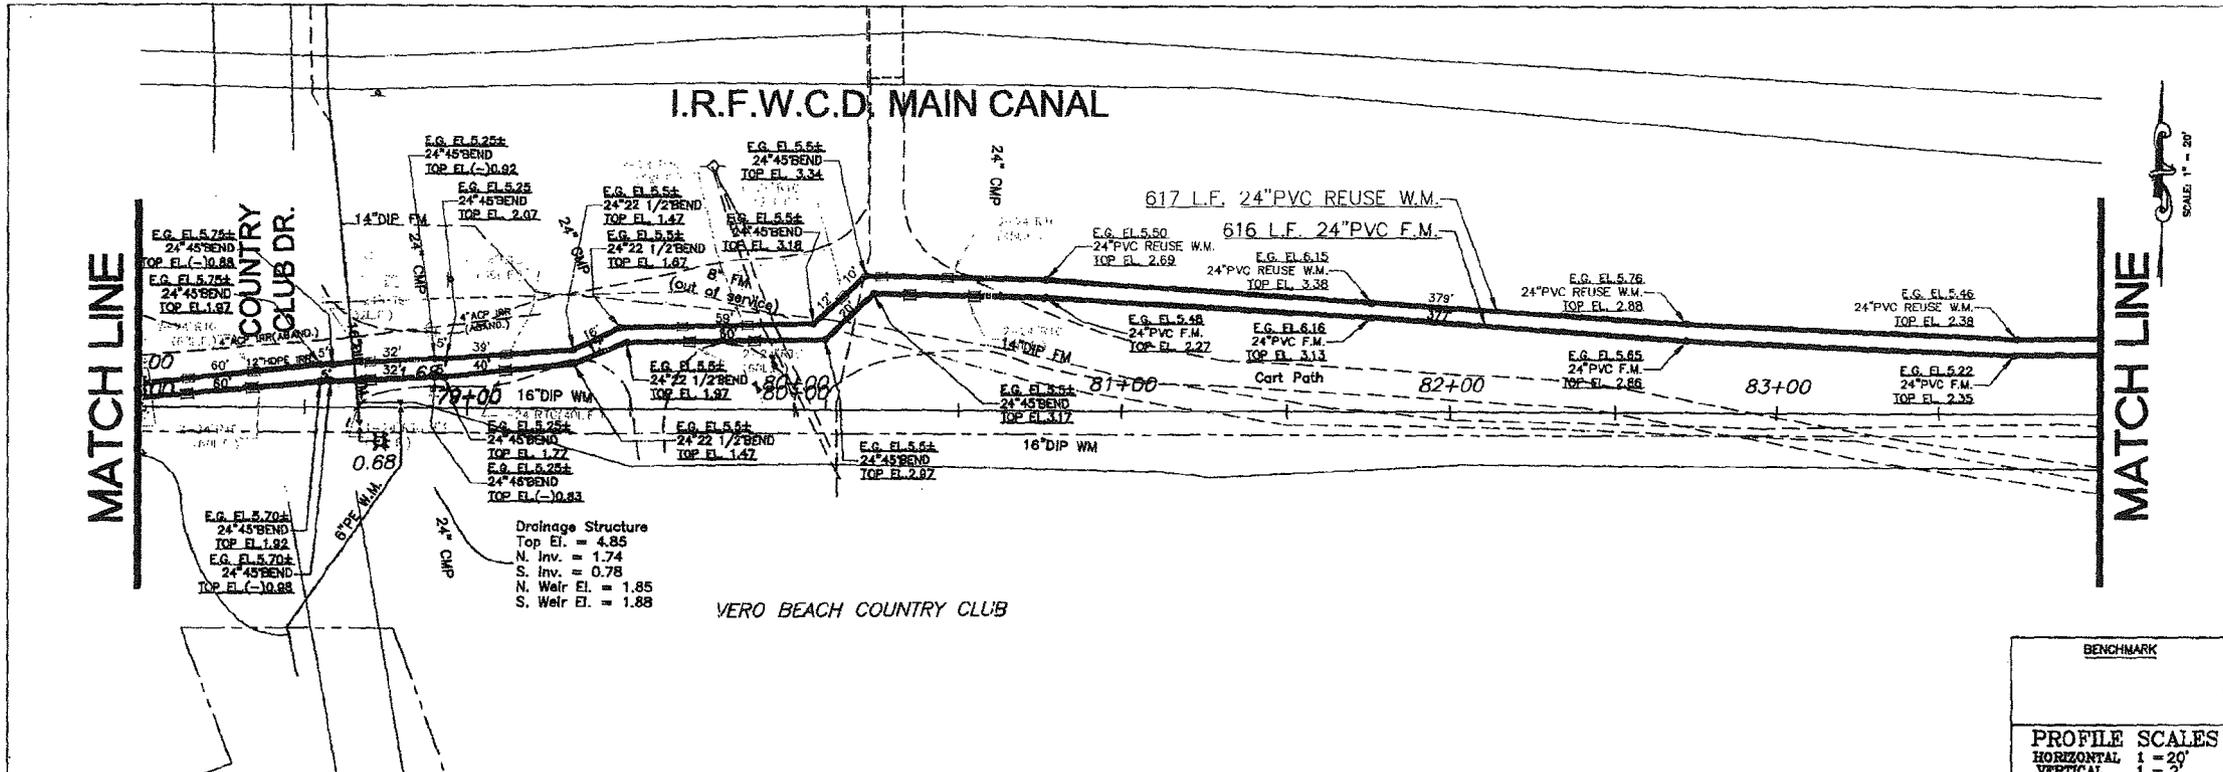

| | | | | | | | | | | | | | | |
|----------|-------------------------------------|---------------|----------|-----------|---|-------|--|-------|----------------------------|-------|---|-------|-------------------------------------|--------------|
| 78+00 | | 79+00 | | 80+00 | | 81+00 | | 82+00 | | 83+00 | | 84+00 | | |
| A | AS-BUILT INFO. FIELD NOTES & SURVEY | R.J.B. | T.A.V. | 8/13/2010 | FORCE MAIN FROM C.O.V.B. W.W.T.P. TO W.T.P. | | | | CITY OF VERO BEACH | | PLAN & PROFILE - I.R.F.W.D. MAIN CANAL R.O.W. | | ROBERT J. MORTON, P.E., FL. # 49429 | DATE |
| REV. NO. | DESCRIPTION | AUTHORIZED BY | DRAWN BY | DATE | AS-BUILT DRAWING | | | | WATER AND SEWER DEPARTMENT | | STA. 78+00 - 84+00 | | 1/21/2010 | CITY PROJECT |

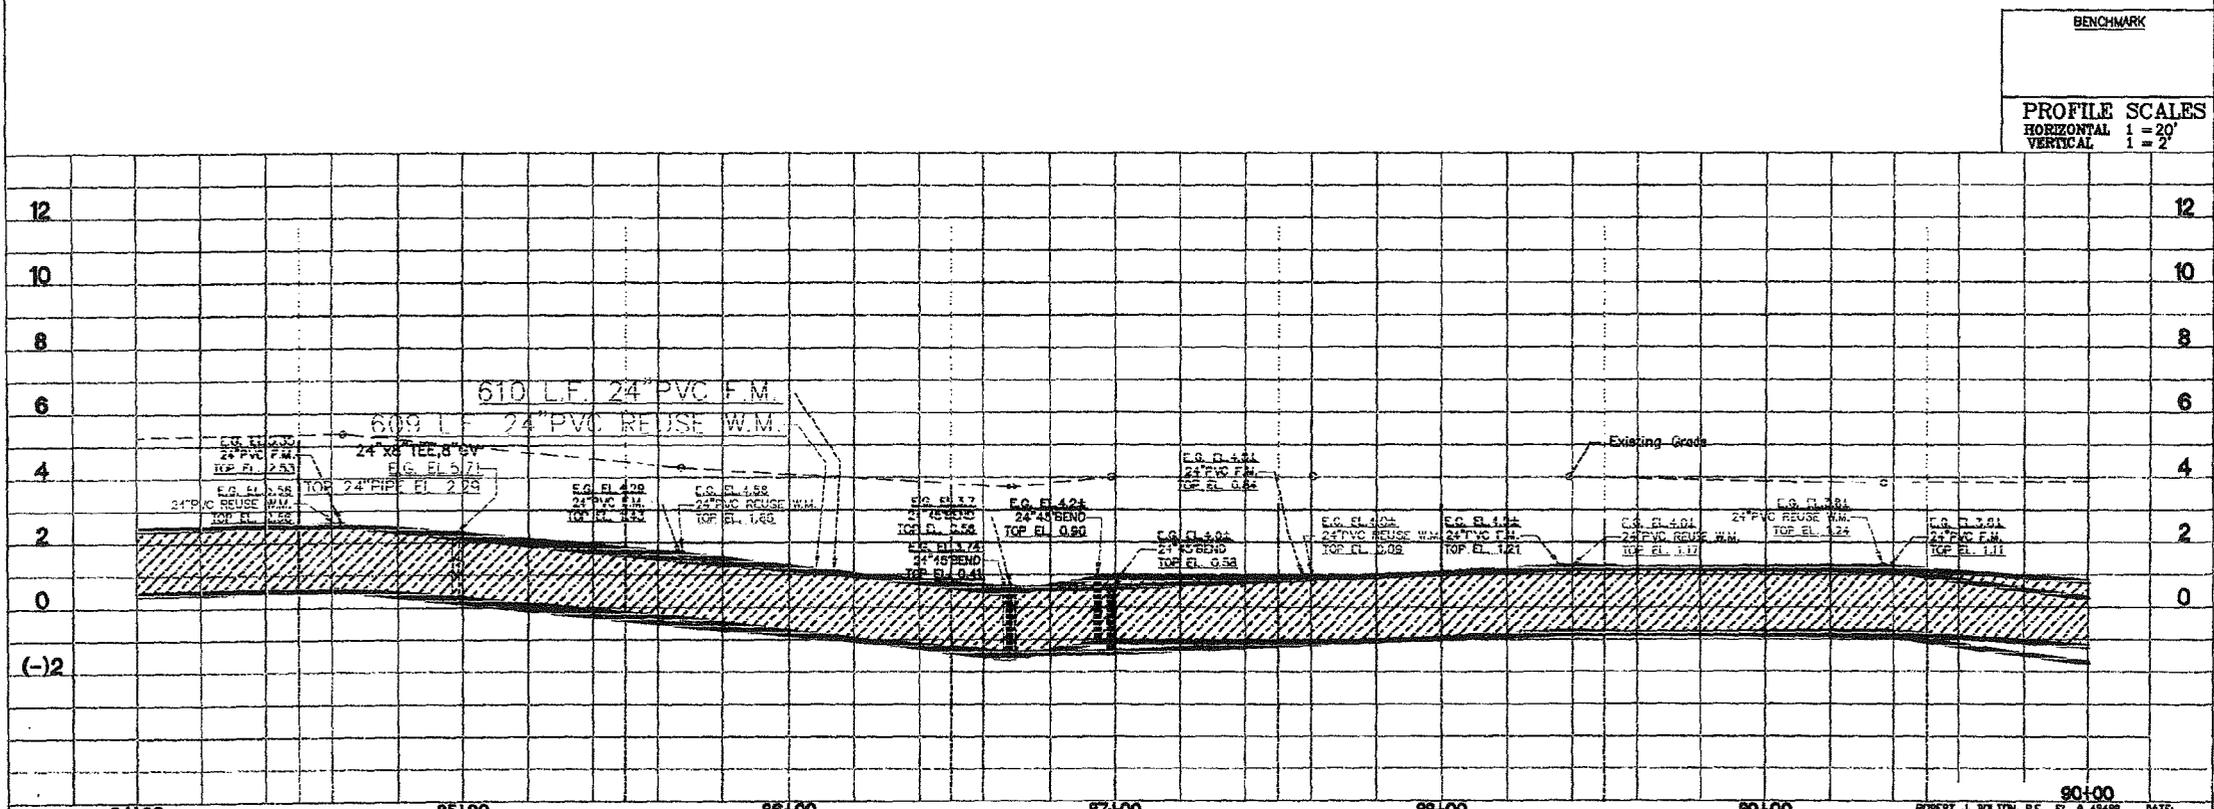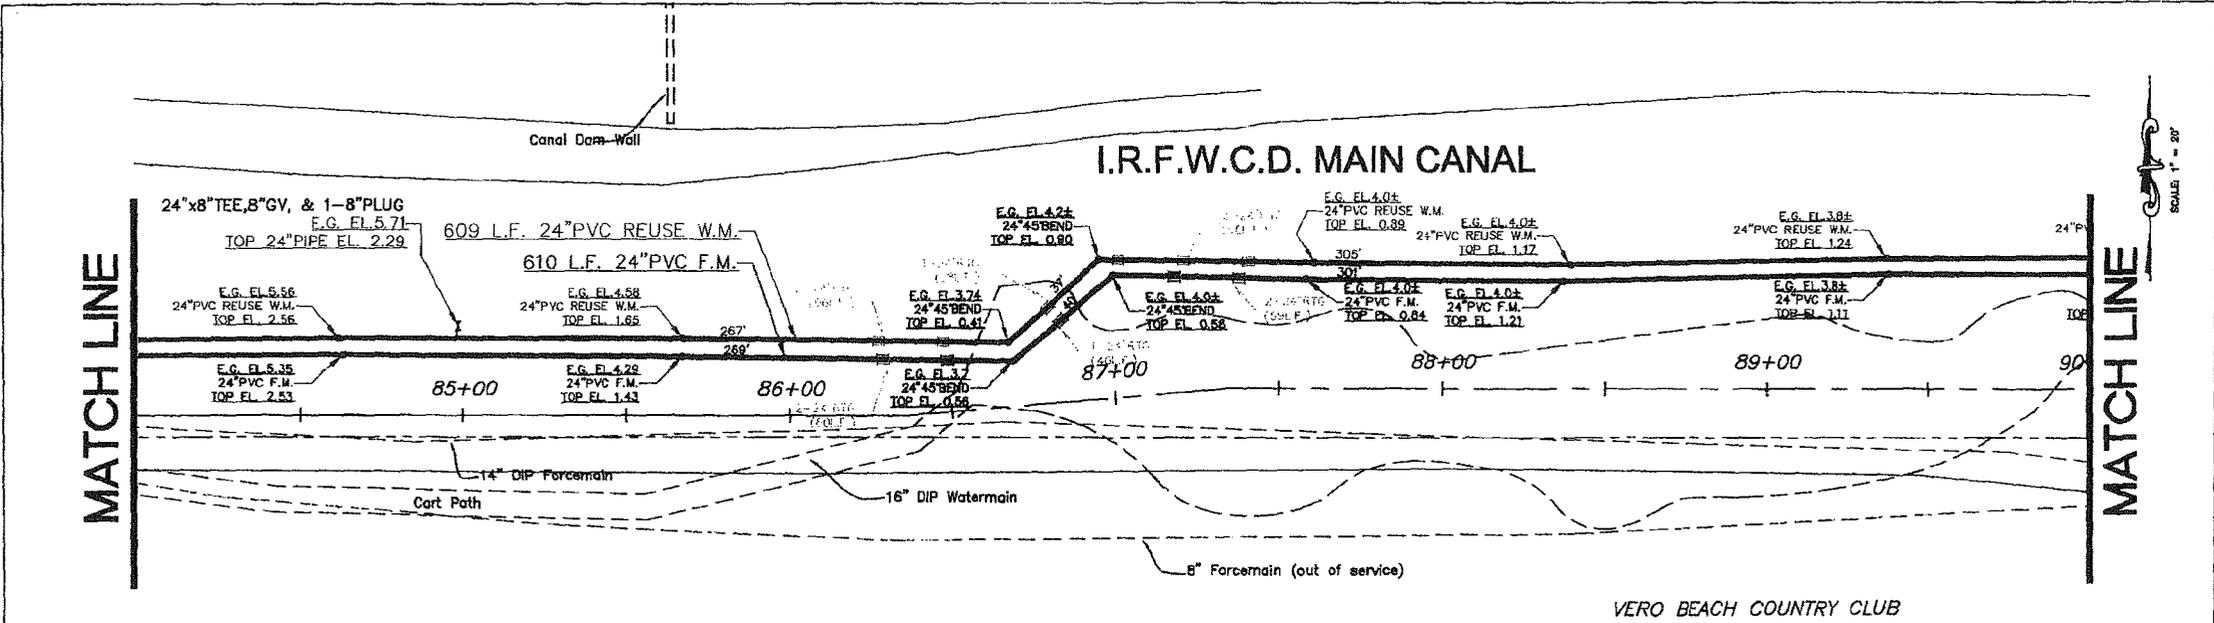

| | | | | | | | | | |
|----------|-------------------------------------|--------------|----------|-----------|---|----------------------------|---|------|---------------------------------------|
| A | AS-BUILT INFO, FIELD NOTES & SURVEY | R.J.B. | T.A.Y. | 8/13/2018 | FORCE MAIN FROM C.O.V.B. W.W.T.P. TO W.T.P. | CITY OF VERO BEACH | PLAN & PROFILE - I.R.F.W.D. MAIN CANAL R.O. | DATE | ROBERT J. BOLTEN, P.E. FL. # 49425 |
| REV. NO. | DESCRIPTION | AUTHORZD. BY | DRAWN BY | DATE | AS-BUILT DRAWING | WATER AND SEWER DEPARTMENT | STA. 84+00 - 90+00 | | NO. WS07014 |

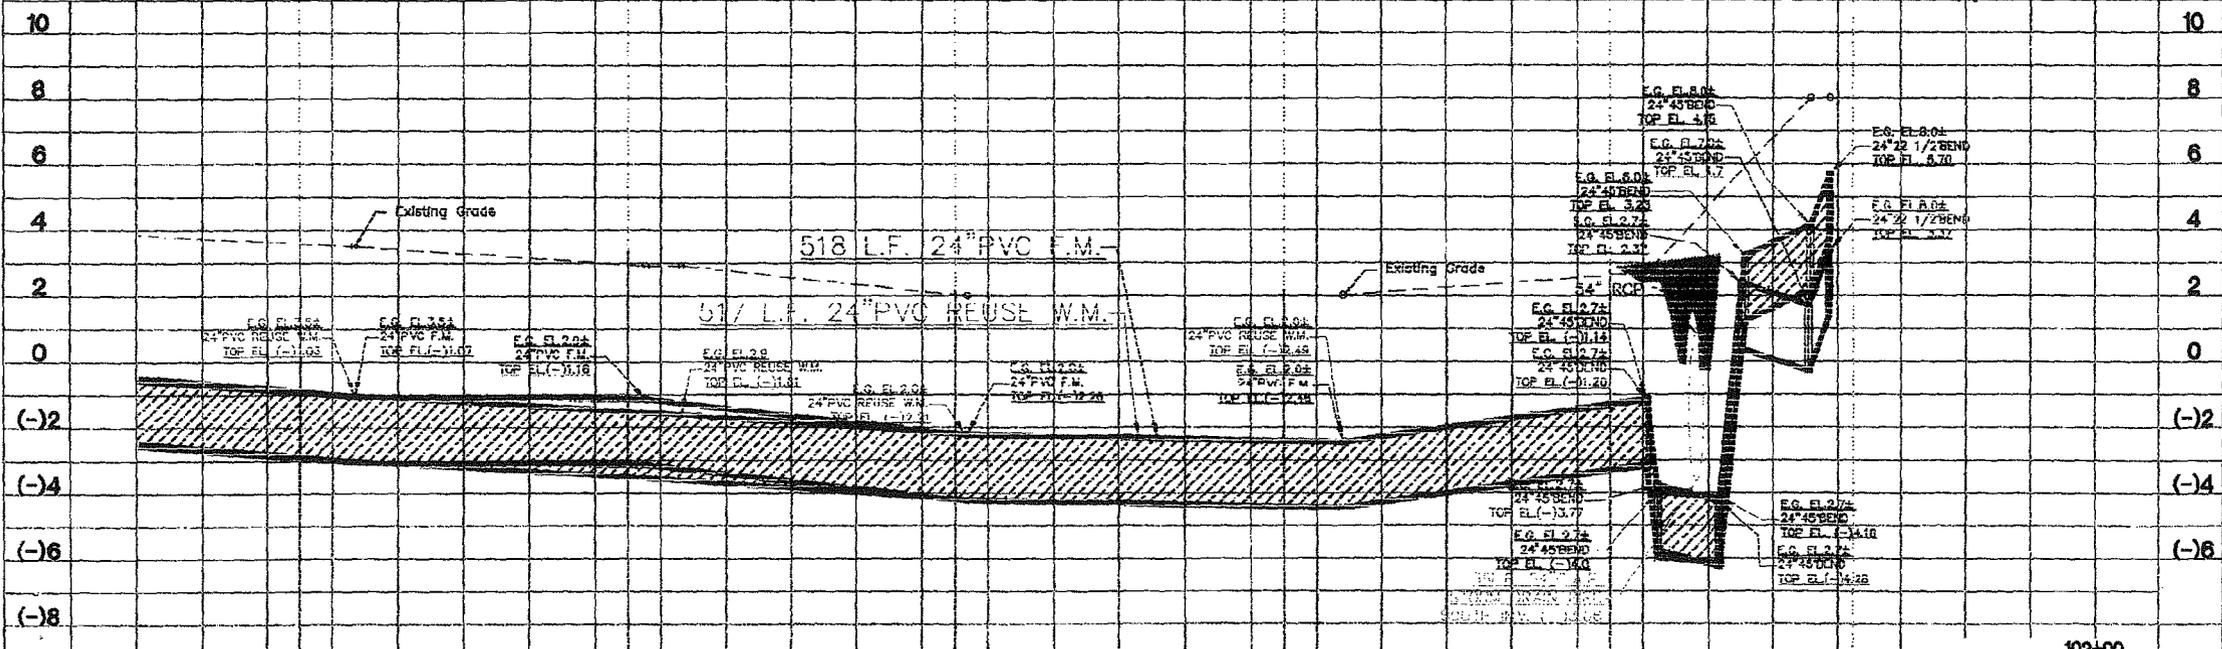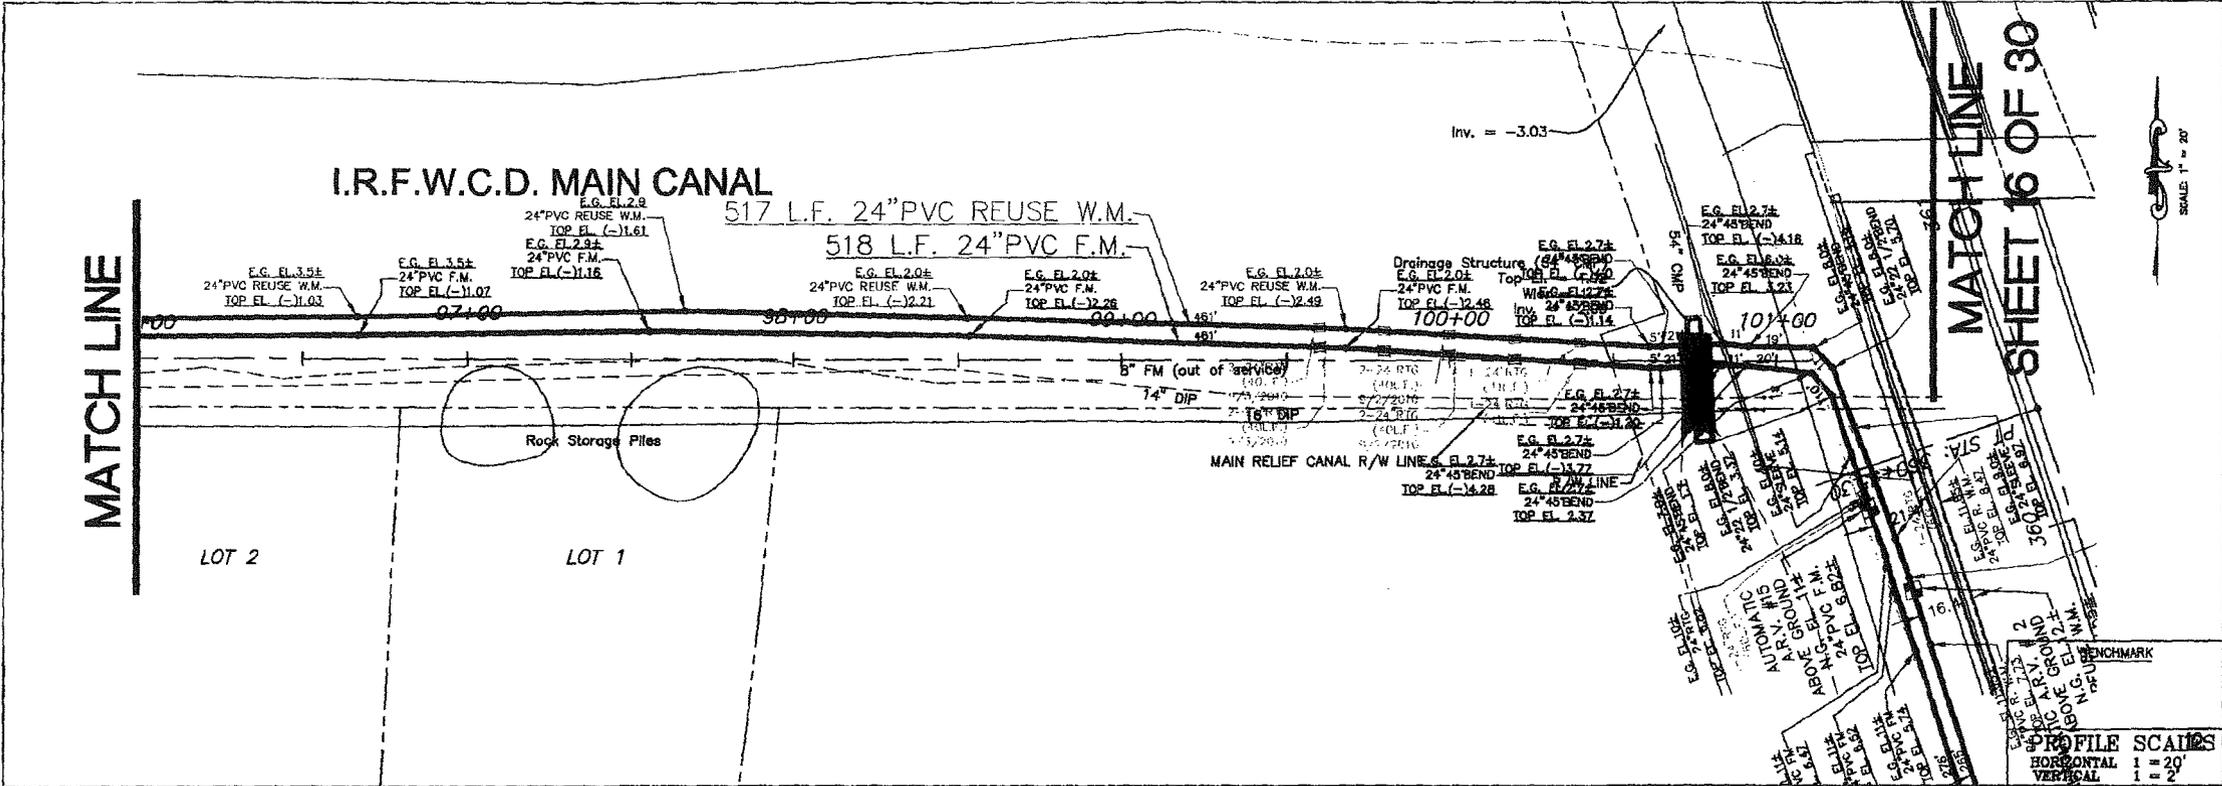

| | | | | | | |
|--|-------|-------|---|--------|--------|--------|
| 96+00 | 97+00 | 98+00 | 99+00 | 100+00 | 101+00 | 102+00 |
| FORCE MAIN FROM C.O.V.B. W.W.T.P. TO W.T.P. AS-BUILT DRAWING | | | | | | |
| CITY OF VERO BEACH WATER AND SEWER DEPARTMENT | | | PLAN & PROFILE - I.R.F.W.D. MAIN CANAL R.O. STA. 96+00 - 102+00 | | | |

SCALE: 1" = 20'

MATCH LINE SHEET 16 OF 30

MATCH LINE

PROFILE SCALES
HORIZONTAL 1" = 20'
VERTICAL 1" = 2'

PERMIT AND INTERLOCAL AGREEMENT

(No. VB-9)

THIS PERMIT and INTERLOCAL AGREEMENT, dated as of the 1st day of January, 2016, by and between **INDIAN RIVER FARMS WATER CONTROL DISTRICT**, a drainage district organized and existing under the General Drainage Laws of the State of Florida, whose address is 7305 4th Street, Vero Beach, Florida, hereinafter referred to as the "District", and the **CITY OF VERO BEACH**, a municipal corporation of the State of Florida, hereinafter referred to as the "Permittee".

NOW, THEREFORE, the District does hereby grant unto the Permittee a permit for a period of one year from January 1, 2016, unless sooner terminated as hereinafter provided, to maintain, inspect, operate and repair a 24" diameter sanitary line on, over and across District right-of-way of the Main Canal at 13th Avenue to Indian River Boulevard, for a distance of approximately 5,183.38 lineal feet at the locations and in accordance with the plans and specifications attached hereto and marked "Exhibit A" and signed by the parties and, by reference, made a part hereof, together with the right of ingress and egress on and over the property at said locations; provided, however, that as a condition precedent to the right herein granted, Permittee agrees to and with the District as follows:

1. That the construction and installation of sanitary line has been in exact conformity with the as-built plans prepared by Robert J. Bolton, P.E., City of Vero Beach Water & Sewer Department.

2. That the rights shall extend only for sanitary line used exclusively by the City of Vero Beach (unless otherwise agreed to by District) and belonging to the Permittee and the Permittee shall not have any right to assign or sublet this Permit or any part thereof unto a third part.

3. Permittee assumes full responsibility for the operation and maintenance of said sanitary line and shall save and hold harmless District from any expense, loss, damage or claim in regard thereto, and the District assumes and shall have no liability in connection therewith.

4. That this Permit is subject always to the paramount right of the District to keep and maintain its drainage district functions and operations, and is subject to revocation and cancellation upon thirty days' notice from District to the City and Permittee.

5.. In no event shall the District be liable for any damages done or caused by the District to the public, to Permittee or any other person, using right-of-way or property subject to this Permit, and Permittee shall save the District, its officers, agents, supervisors, and employees harmless from any costs, charge or expense or claim or demand of any person against the District, to the extent permitted by law and subject to the limits provided by Section 768.28, Florida Statutes, arising from or pertaining to any use by Permittee made of the property or structures subject to this Permit. Permittee shall, as a condition to the effectiveness of this Permit, provide to District evidence satisfactory to District, of adequate commercial general liability insurance providing all risks coverage which protects Permittee and the District, its officers, agents, supervisors,

and employees from any and all claims and liabilities for bodily injury and property damage arising from Permittee operations of its use of the District right-of-way or property subject to this permit. Coverage shall be provided in a form no more restrictive than the latest edition of the commercial general liability policy filed by the Insurance Service Office. Policies shall be endorsed to name District as an additional insured and shall include provisions for at least thirty (30) days advance notice to District by the insurer prior to any policy change, amendment, termination, or expiration of coverage. Permittee shall direct its insurance agent to provide District with a policy, an additional insured endorsement containing language no less restrictive than ISO Form CG 20 10 07 04 or ISO Form CG 20 33 07 04, and a certificate of insurance. This Permit shall be null and void if adequate insurance is not maintained by the Permittee.

6. The District may, on thirty days' written notice to the Permittee, require cessation of use within District's right-of-way, together with removal or alteration of any installation or construction on District right-of-way.

7. The Permittee shall at all times maintain cable markers above ground at 100 foot intervals to show the location of any underground objects. The sanitary line shall be constructed and installed to permit the crossing of heavy equipment used by the District for the maintenance of its laterals, sub-laterals and canals and for any similar heavy equipment used by land owners within the District. In any case where the sanitary line crosses a pipe or culvert used for drainage or irrigation purposes, or a pipe or culvert is needed hereafter for drainage or irrigation of adjacent lands, and the same is deemed by District or an adjacent landowner to be required to be installed, repaired or replaced, then upon twenty-four (24) hours notice, Permittee shall, at Permittee's sole cost and expense, be available at the location of, and arrange for such installation, repair or replacement with personnel and equipment to insure that the sanitary line does not endanger or prevent the installation, repair, replacement or use of pipes or culverts for drainage or irrigation purposes. The District has the right to determine the exact location of the sanitary line within the said right-of-way in order that the location of same shall not interfere with the District's functions and operations and of the District land owners.

8. Permittee shall advise District's office prior to commencement or completion of all construction.

9. Permittee shall not discharge any pollutants, contaminants or deleterious materials into waters or structures owned or maintained by, or subject to the jurisdiction of District, nor permit anything to obstruct the flow of water, and shall save and hold District harmless from an expense, loss or damage to District or others by any such discharge or obstruction, remedying or removing the same immediately upon request by District.

10. This Permit shall exist only so long as Permittee may be in full compliance with all requirements of the Department of Environmental Protection for the State of Florida, as such requirements relate to this project, and if, at any time, the Permittee shall fail to meet such requirements, then this Permit shall, ipso facto, immediately become null and void.

11. Permittee, as a condition to the continuance of this Permit, shall reimburse District, immediately on demand, for any fees for testing or other professional services, costs or expenses to District associated with or arising from Permittee's use of District right-of-way.

12. The Permittee shall pay to the District an annual rent of One Thousand Six Hundred Sixty Eight and 89/100 Dollars (\$1,668.89), payable in advance. In addition to the permit fee payable hereunder, if the permit applied for or the use for which the permit is granted requires engineering or legal work for purposes of processing and approval by District, then Permittee shall pay promptly when invoiced all engineering and legal fees incurred by District in connection herewith and shall indemnify District for the same, saving and holding District harmless from any liability in connection therewith.

13. This Permit shall be effective January 1, 2016, and continue for a period of one year unless sooner terminated as provided herein.

14. In the event that this Permit is canceled or terminated, the Permittee shall, at its expense, promptly remove the sewer sanitary line from the right-of-way of the District.

15. This Permit shall be considered to be a license only, for the limited purpose of installation, placement and maintenance of the improvements specified on the face hereof, and does not convey any other right, title or interest of the District in the subject right-of-way property.

16. In the event of any dispute arising hereunder, the parties agree that, as a condition precedent to litigation, the parties shall first submit the same to non-binding mediation with a Florida Circuit Court certified civil mediator with the cost of such mediation shared equally between the parties.

17. Permittee assumes full responsibility for any construction, operation or maintenance on District property or right-of-way subject to the Permit and understands and agrees that Permittee's use of District property for Permittee's purposes and benefit is at Permittee's sole risk; any loss or damage to Permittee's property, installations, facilities or personnel while on District property or right-of-way, regardless of the cause of the same, including, without limitation, negligence or want or care on the part of District, its agents or employees, whether by reason of the provision of Chapter 556, Florida Statutes, or otherwise, is Permittee's and not District's (except as may be otherwise provided by Section 768.28, Florida Statutes) and, as a condition of this Permit, Permittee promises, covenants and agrees that neither Permittee, nor anyone claiming by, through or under Permittee, shall have any claim or cause of action against District by reason of such loss or damage. The parties hereto further acknowledge and agree that District has no obligation to allow Permittee to enter upon or use District's property or right-of-way, and does so only in consideration of Permittee's release of District from any responsibility or liability whatsoever, including for damage caused by District's negligence, now or in the future, and Permittee agrees that it is able, at its own expense, to insure against loss or damage, without granting any right of subrogation to claims against District or Permittee.

18. This Permit may not be assigned or sublet to a third party and any transfer of Permittee's property abutting District's property or right-of-way shall, ipso facto and without more, cancel, nullify and revoke this Permit.

19. Permittee understands, acknowledges and agrees that the business of District is digging within the area of its rights of way and sole responsibility for damage to any facilities, structures or property located underground is Permittee's and not the District's.

20. In consideration of the grant of this Permit, Permittee, if a public or private body with the power of eminent domain, expressly waives and relinquishes power of eminent domain or condemnation of the property as to which this Permit applies for the use for which the Permit is granted. This clause shall survive termination or expiration of this Permit.

IN WITNESS WHEREOF, said District has caused these present to be executed in its name by its Secretary and its corporate seal hereto affixed, by due authority of its Board of Supervisors, this ____ day of _____, 2016.

Signed, sealed and delivered
in the presence of:

as to District

(SEAL)

INDIAN RIVER FARMS WATER CONTROL DISTRICT

By: _____
David E. Gunter, Secretary

Permittee hereby accepts the terms of this Permit, and covenants and agrees that it will comply with the terms and condition of this Permit.

Dated this ____ day of _____, 2016.

Signed, sealed and delivered
in the presence of:


as to Permittee

CITY OF VERO BEACH


By: _____
Mayor

Attest: _____
City Clerk

(SEAL)

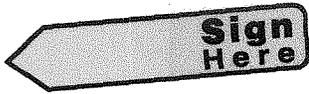

| CITY OF VERO BEACH | APPROVED | DATE |
|--------------------|----------|---------|
| City Manager | | |
| City Attorney | WRC | 1/8/16 |
| City Clerk | | |
| Utilities - WIS | TJB | 1/12/16 |
| Public Works | | |
| Finance | | |
| Human Resources | | |
| Planning | | |
| | | |
| | | |

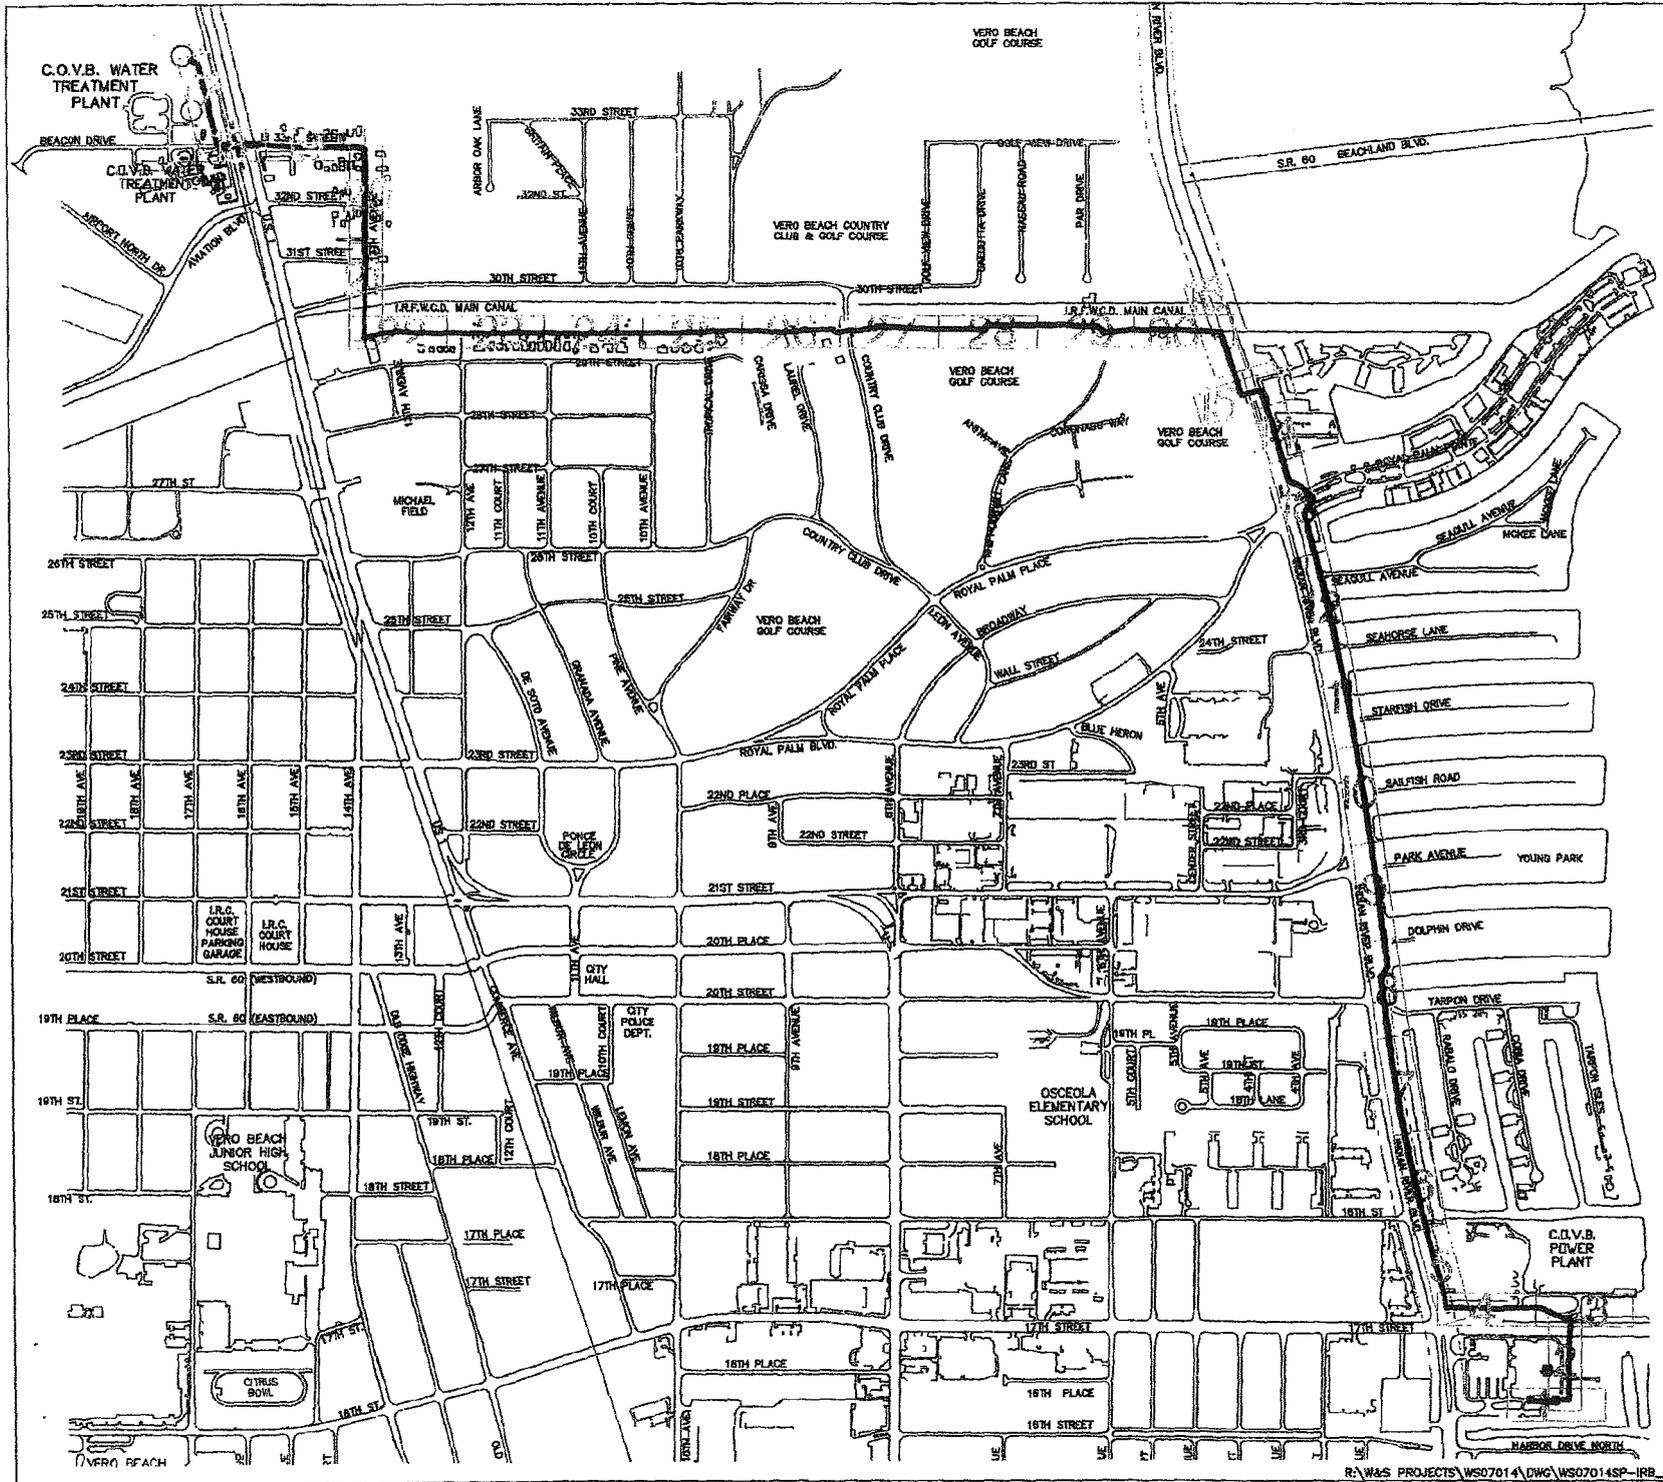

SCALE 1" = 400'


EXHIBIT "A"
(11 pages)

- LEGEND**
- AS-BUILT SHEET NO. 30
 - 24" PVC FM
 - 24" HDPE FM
 - 24" PVC REUSE WM

PLOT DATE: 10/05/2010

| REV. NO. | DESCRIPTION | AUTHORIZED BY | DRAWN BY | DATE |
|--|---|----------------|--------------------------------------|-----------------|
| | FORCE MAIN FROM C.O.V.B. W.W.T.P. TO W.T.P. AS-BUILT DRAWING | | | |
| | SHEET LAYOUT | SCALE 1" = 20' | DRAWN BY T.A.Y. CHECKED BY R.J.B. | DATE 10/17/2010 |
| CITY OF VERO BEACH WATER AND SEWER DEPARTMENT | | | | |

10/5/10
 ROBERT J. BULTON, P.E.
 DATE

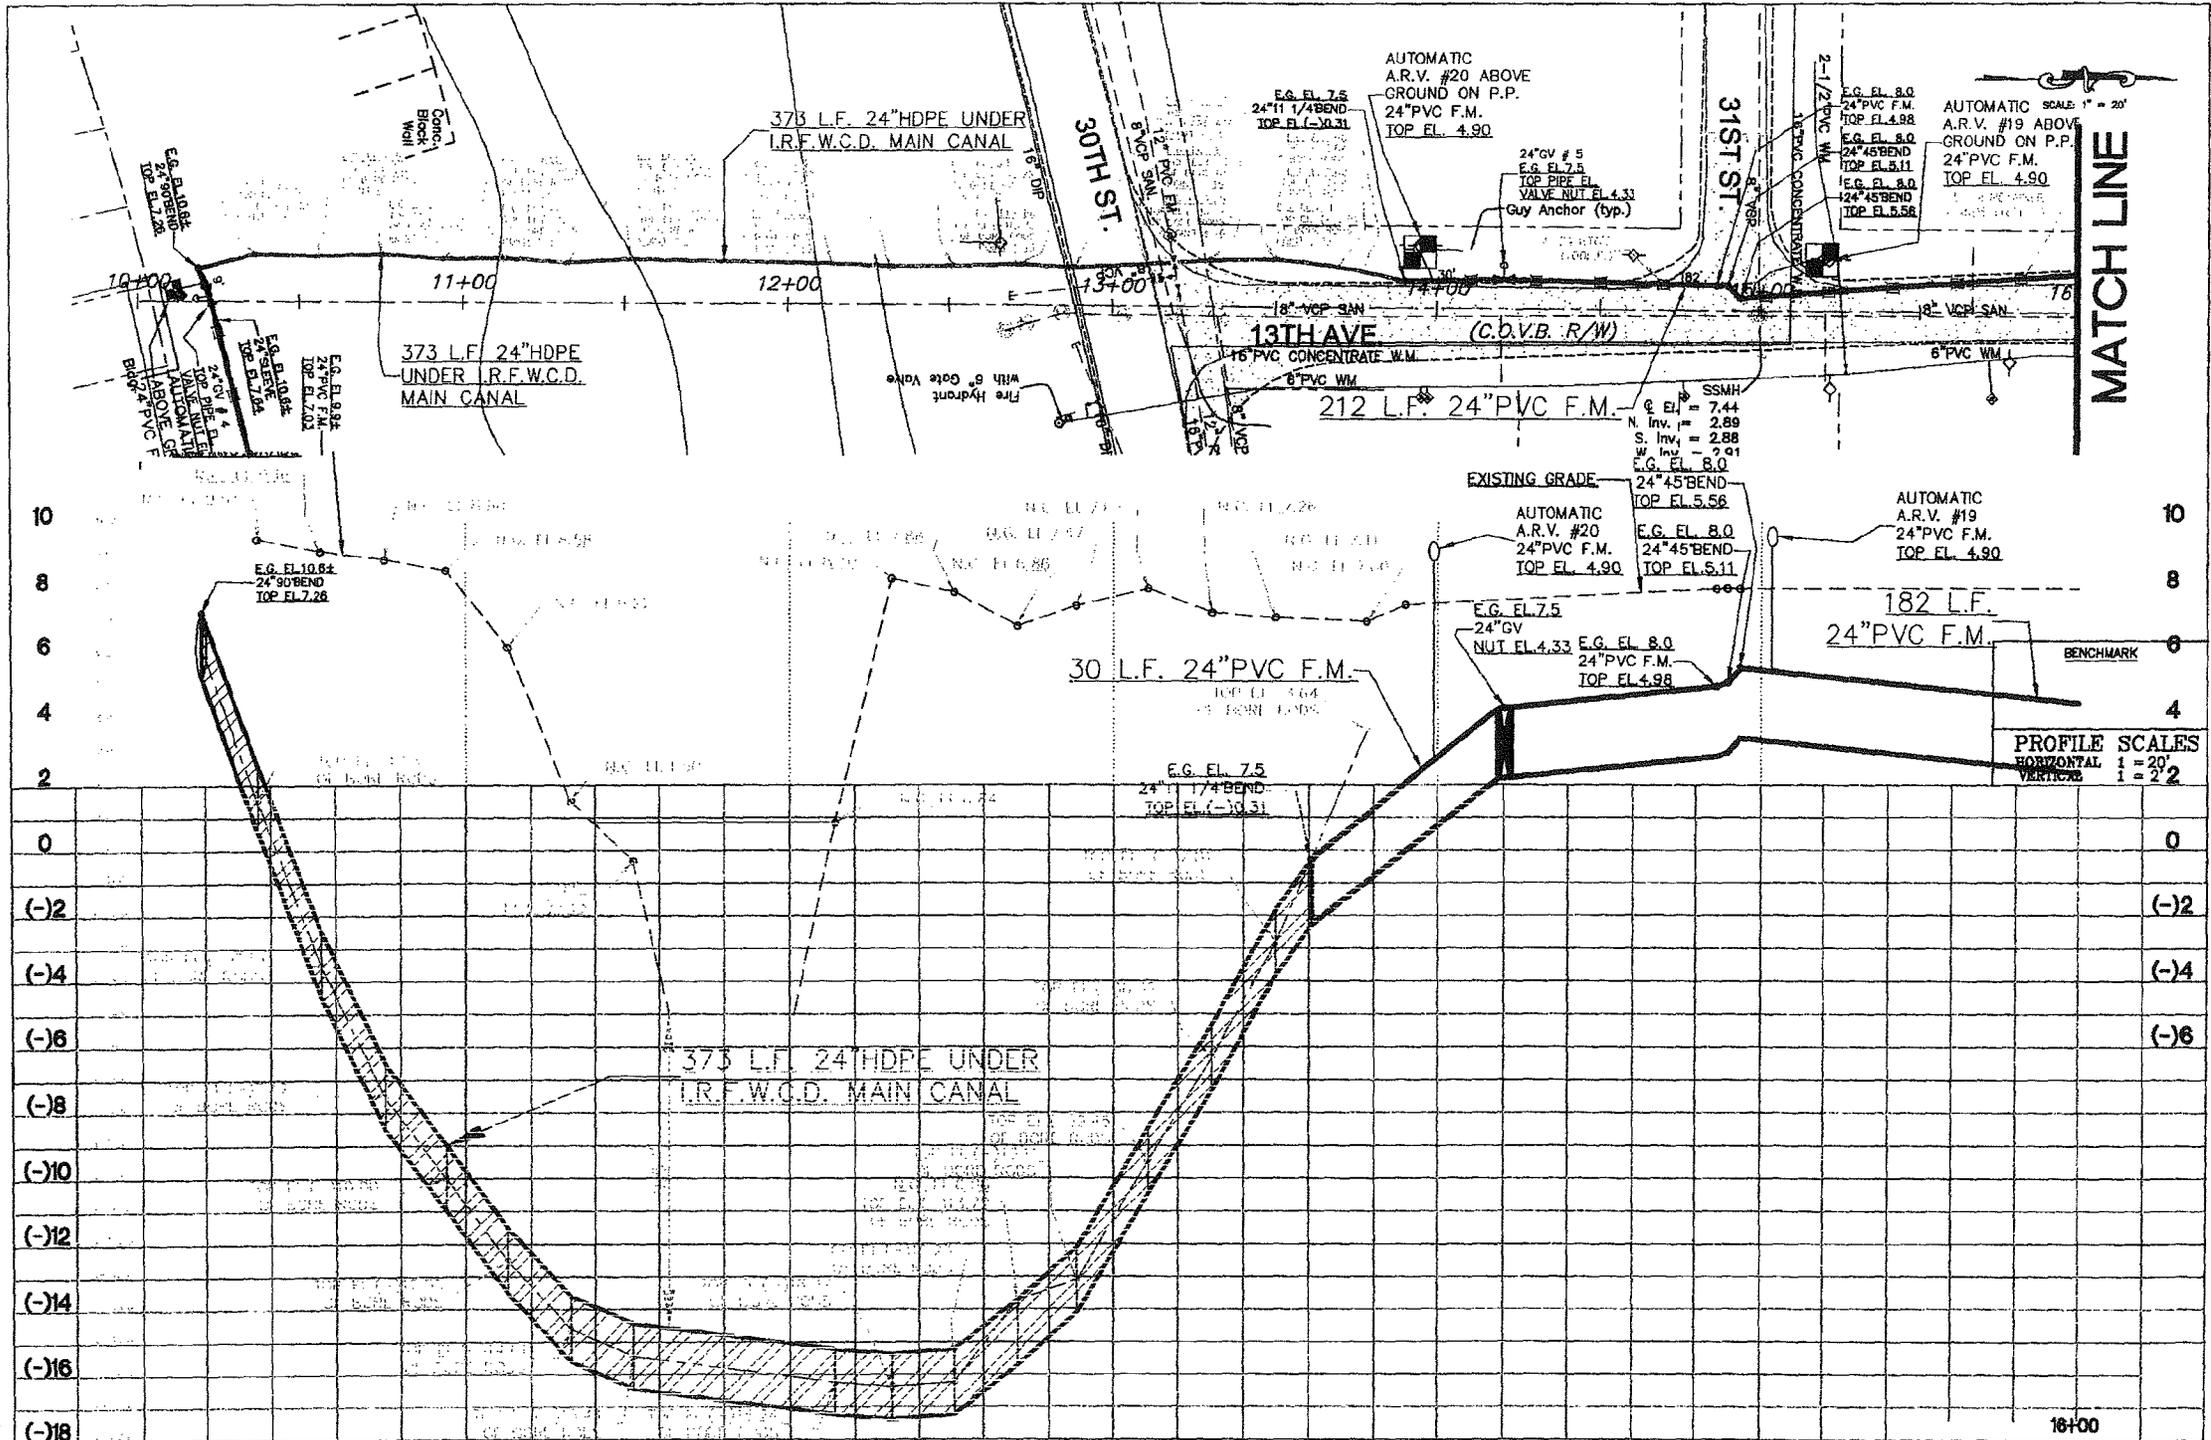

MATCH LINE


PROFILE SCALES
 HORIZONTAL 1" = 20'
 VERTICAL 1" = 2'

| | | | | | | | | | |
|----------|-------------|---------------|----------|------|---|--|--|---|----------------|
| REV. NO. | DESCRIPTION | AUTHORIZED BY | DRAWN BY | DATE | FORCE MAIN FROM C.O.V.B. W.W.T.P. TO W.T.P. AS-BUILT DRAWING | CITY OF VERO BEACH WATER AND SEWER DEPARTMENT | PLAN & PROFILE - C.O.V.B. W.W.T.P. STA. 10+00 - 16+00 | ROBERT J. BELTON, P.E. FL # 49429 DATE 12/2010 CITY PROJECT NO. W507014 | SHEET 21 OF 30 |
|----------|-------------|---------------|----------|------|---|--|--|---|----------------|


MATCH LINE

MATCH LINE

SCALE 1" = 20'

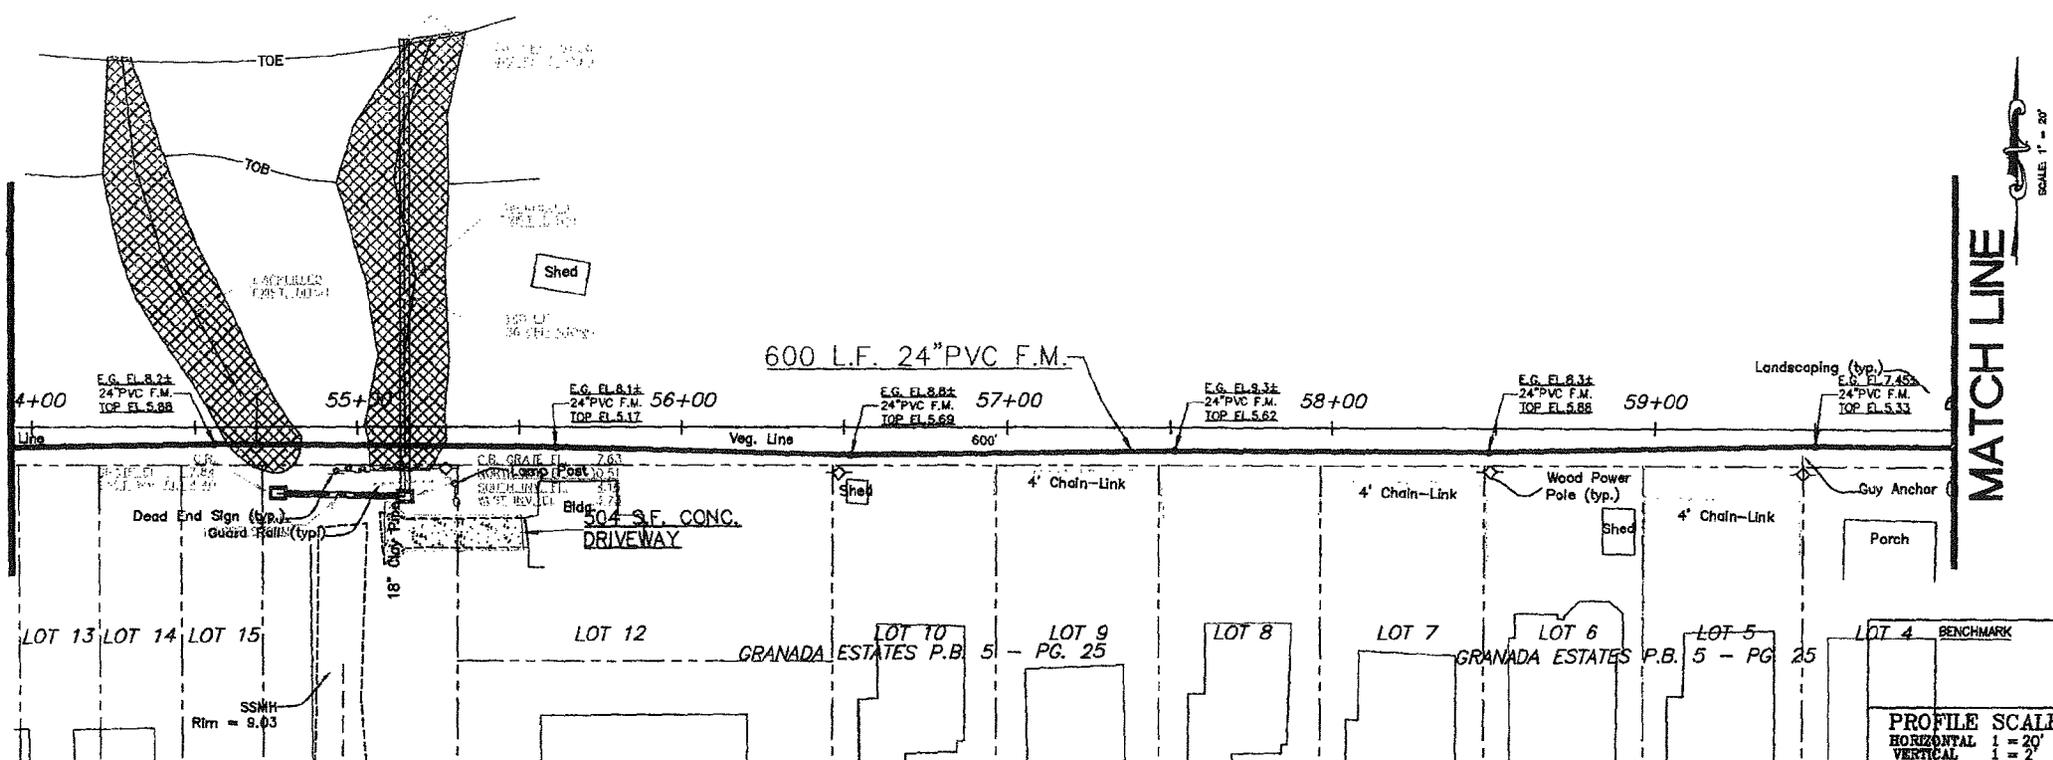

PROFILE SCALES
 HORIZONTAL 1" = 20'
 VERTICAL 1" = 2'

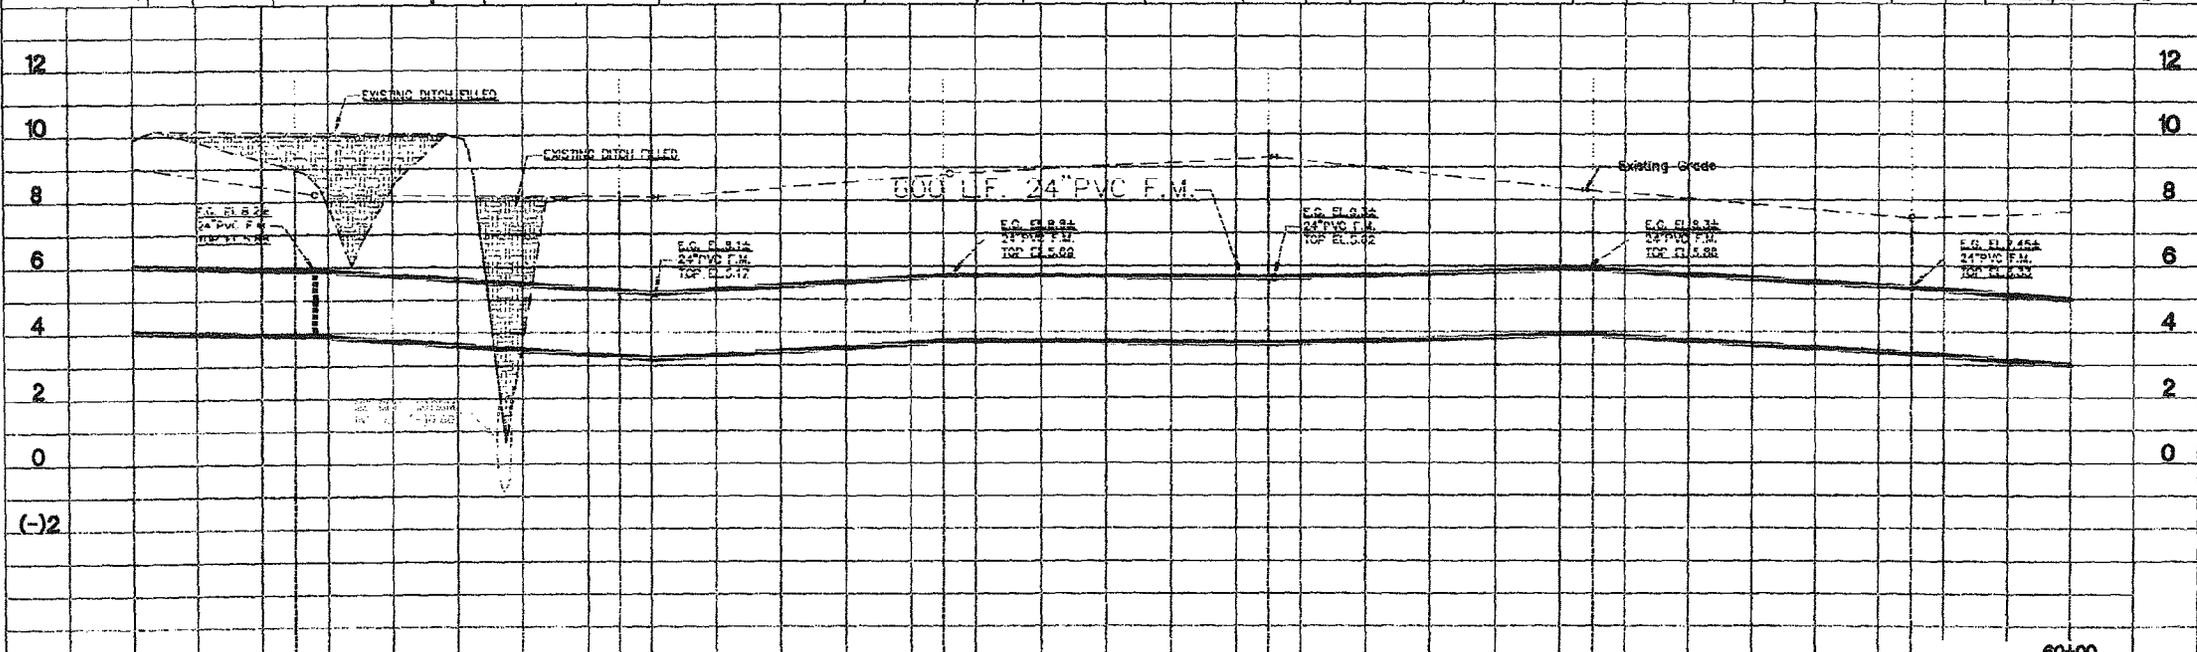

| | | | | | | | | | | | | | |
|----------|-------------------------------------|-----------------|--------|-------------|---|------------------|------|--------------------|------|----------------------------|------|---|--------------------|
| REV. NO. | DESCRIPTION | AUTHOR/APP'D BY | DATE | DESCRIPTION | DATE | DESCRIPTION | DATE | DESCRIPTION | DATE | DESCRIPTION | DATE | DESCRIPTION | DATE |
| A | AS-BUILT INFO. FIELD NOTES & SURVEY | R.J.B. | T.A.Y. | 9/15/2010 | FORCE MAIN FROM C.O.V.B. W.W.T.P. TO W.T.P. | AS-BUILT DRAWING | | CITY OF VERO BEACH | | WATER AND SEWER DEPARTMENT | | PLAN & PROFILE - I.R.F.W.D. MAIN CANAL R.O.W. | STA. 54+00 - 60+00 |


ROBERT J. ROLTON, P.E. FL # 49429 DATE: 12/2014 CITY PROJECT NO. 07014 SHR27.3 of 30

I.R.F.W.C.D. MAIN CANAL


SCALE: 1" = 20'

MATCH LINE



MATCH LINE

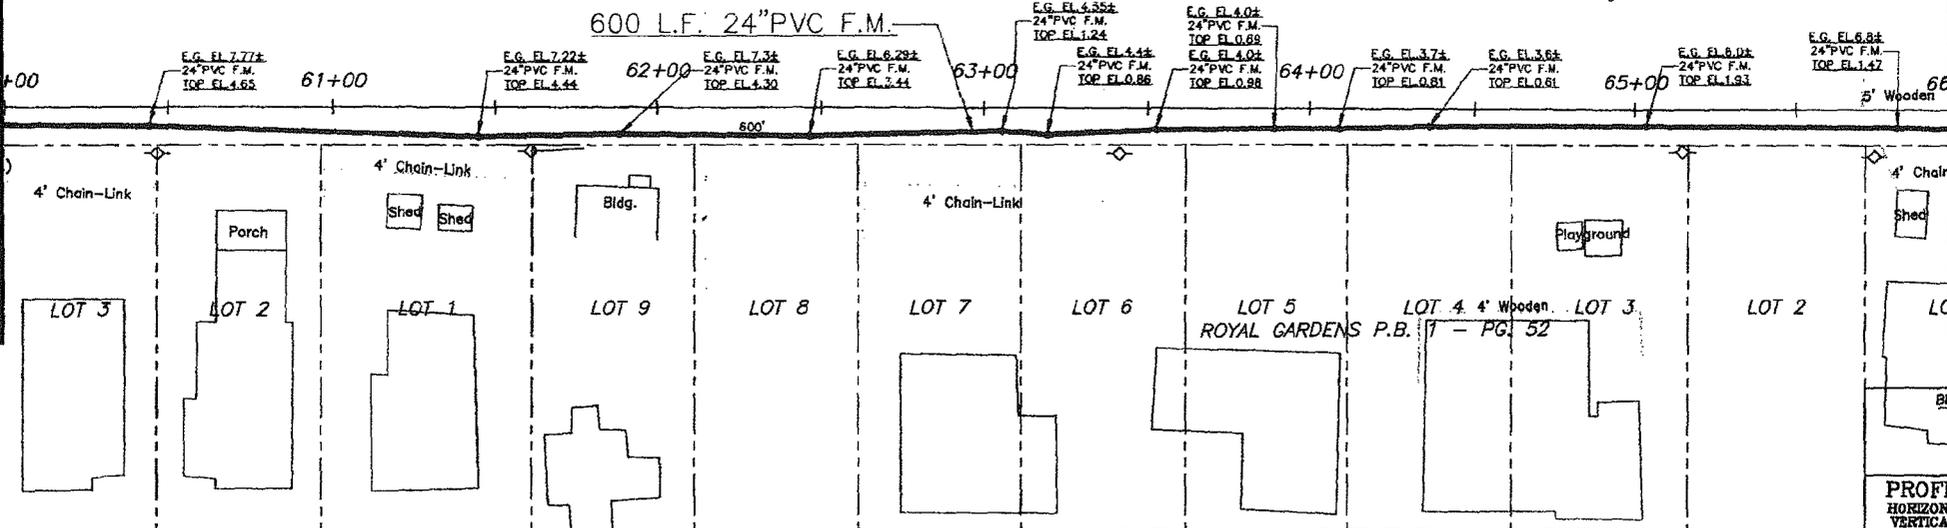

PROFILE SCALES
HORIZONTAL 1" = 20'
VERTICAL 1" = 2'

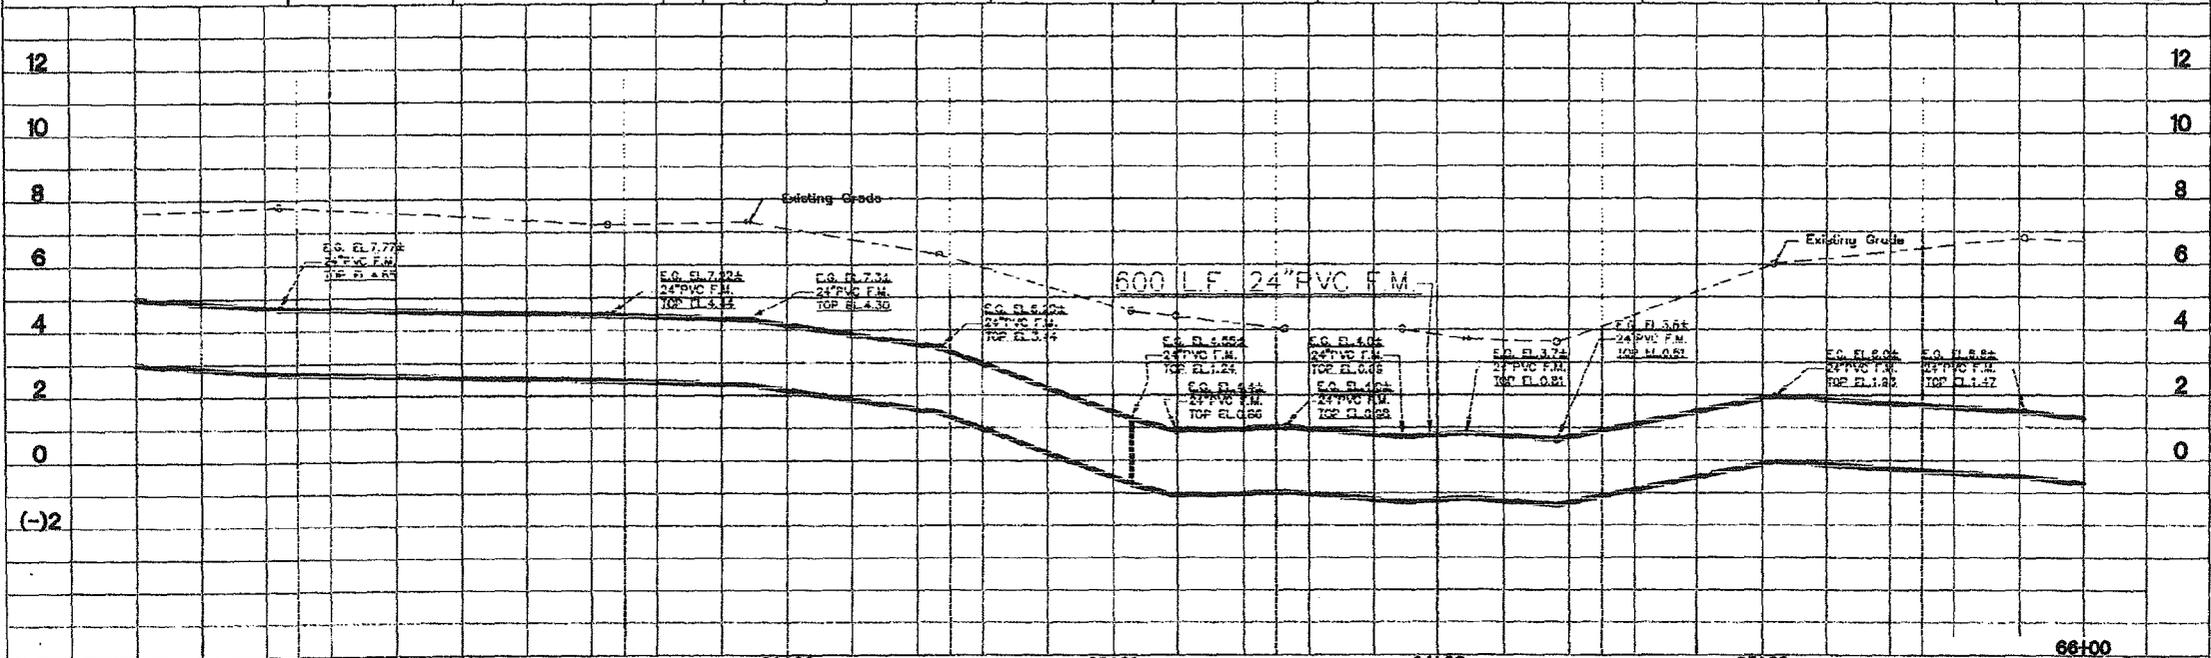

| | | | | | | |
|---|-------|-------------|---------------|---|-----------|-------|
| 60+00 | 61+00 | 62+00 | 63+00 | 64+00 | 65+00 | 66+00 |
| A AS-BUILT INFO. FIELD NOTES & SURVEY | | R.J.B. | T.A.Y. | FORCE MAIN FROM C.O.V.B. W.W.T.P. TO W.T.P. | | |
| REV. NO. | | DESCRIPTION | AUTHORIZED BY | DRAWN BY | DATE | |
| | | | | | 8/13/2010 | |
| CITY OF VERO BEACH | | | | WATER AND SEWER DEPARTMENT | | |
| PLAN & PROFILE - I.R.F.W.D. MAIN CANAL R.O. | | | | NO. WS07014 | | |
| STA. 60+00 - 66+00 | | | | SHEET 24 OF 30 | | |

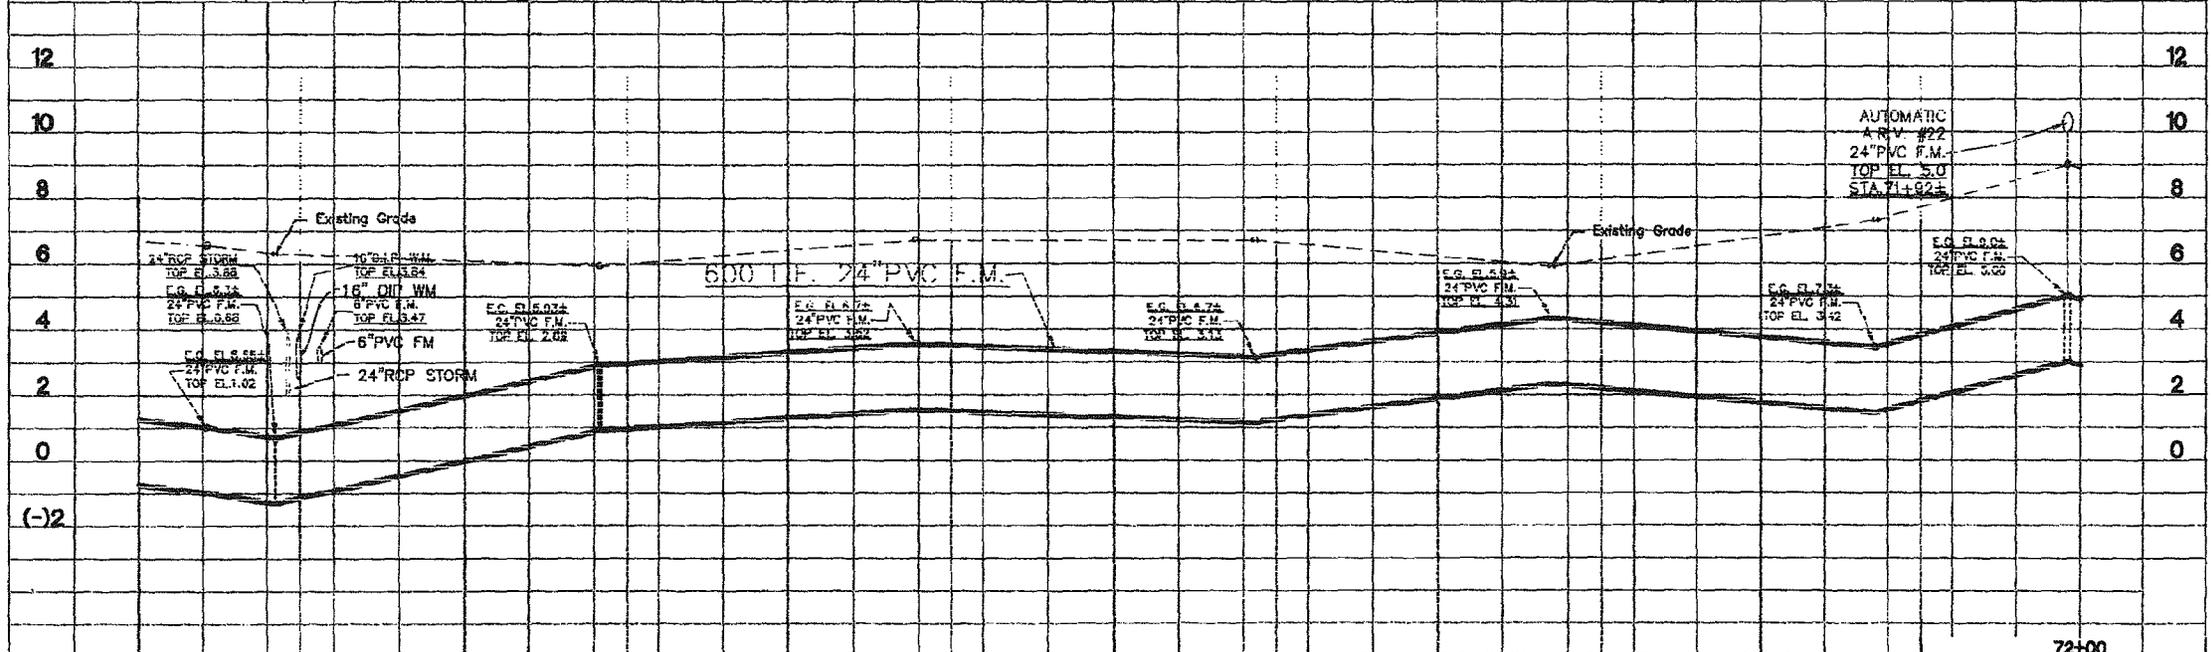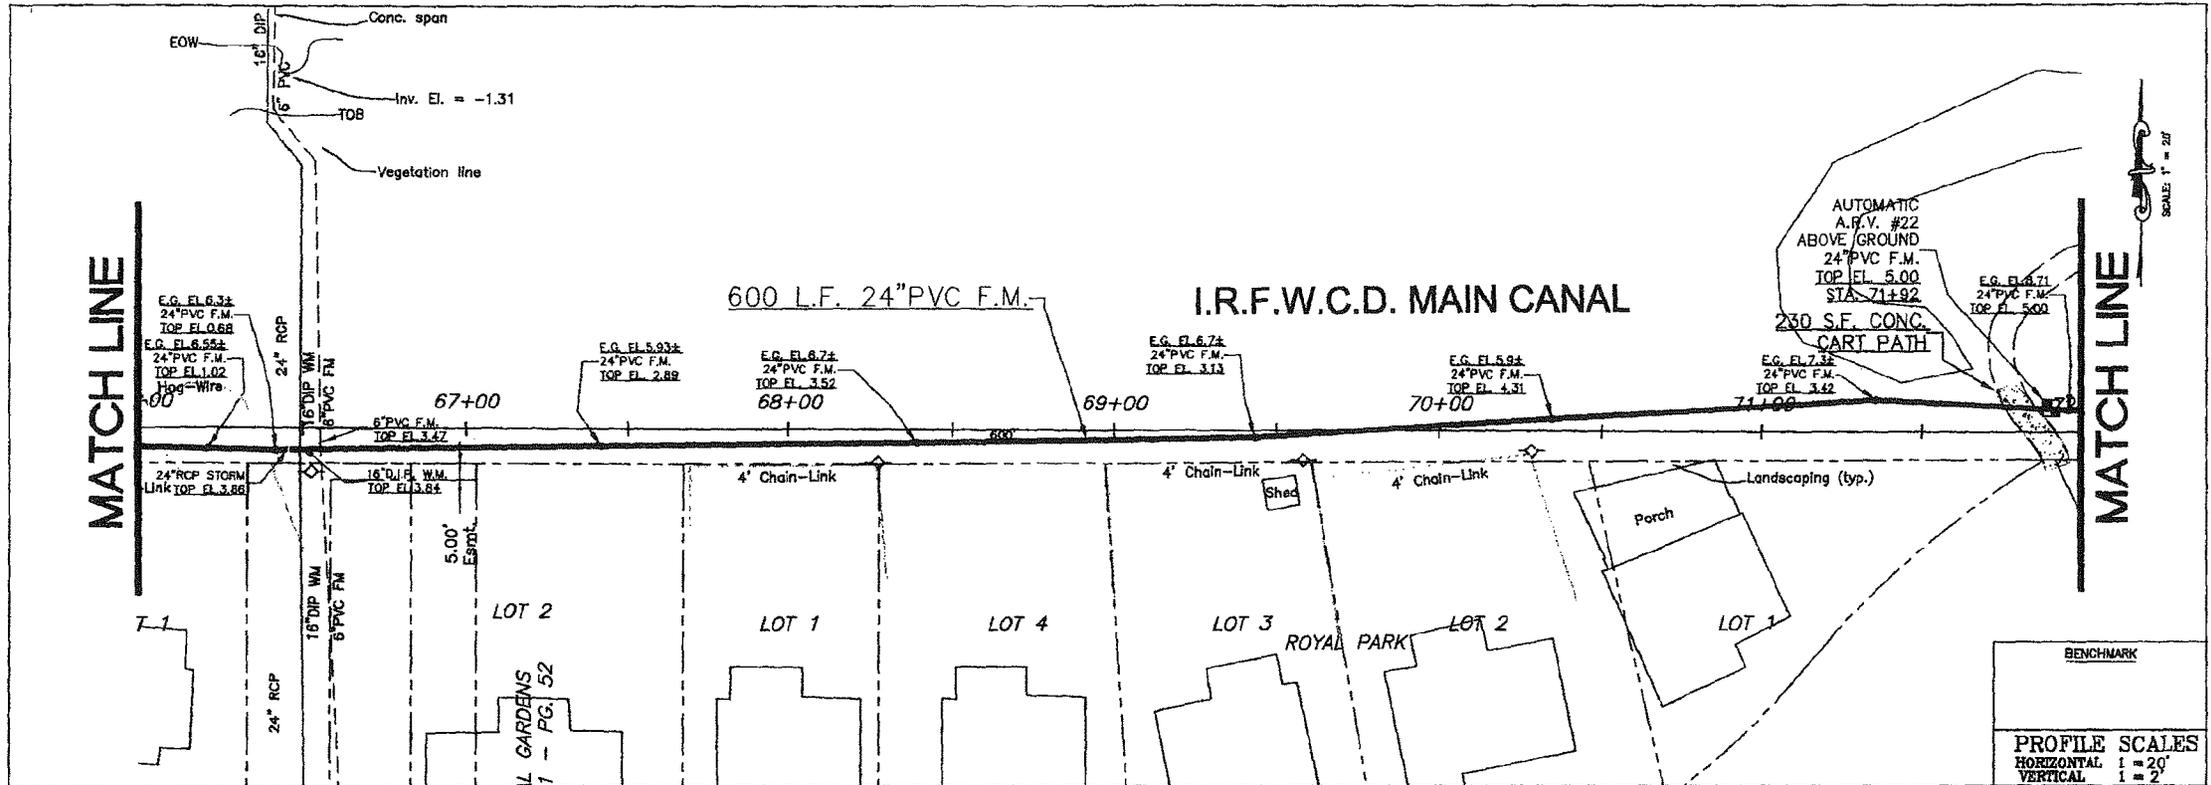


| | | | | | | |
|----------|------------------------------------|------------|----------|-----------|--|--|
| 66+00 | 67+00 | 68+00 | 69+00 | 70+00 | 71+00 | 72+00 |
| A | AS-BUILT RFP, FIELD NOTES & SURVEY | R.L.B. | T.A.Y. | 9/13/2010 | FORCE MAIN FROM C.Q.V.B. W.W.T.P. TO W.T.P. | AS-BUILT DRAWING |
| REV. NO. | DESCRIPTION | AUTHZD. BY | DRAWN BY | DATE | CITY OF VERO BEACH WATER AND SEWER DEPARTMENT | PLAN & PROFILE - I.R.F.W.D. MAIN CANAL R.O.V. STA. 66+00 - 72+00 |

ROBERT J. BOLTON, P.E. FL # 49429 DATE: 12/21/2010 CITY PROJECT No. WS07014 SHEET 25 OF 30

I.R.F.W.C.D. MAIN CANAL

MATCH LINE

MATCH LINE

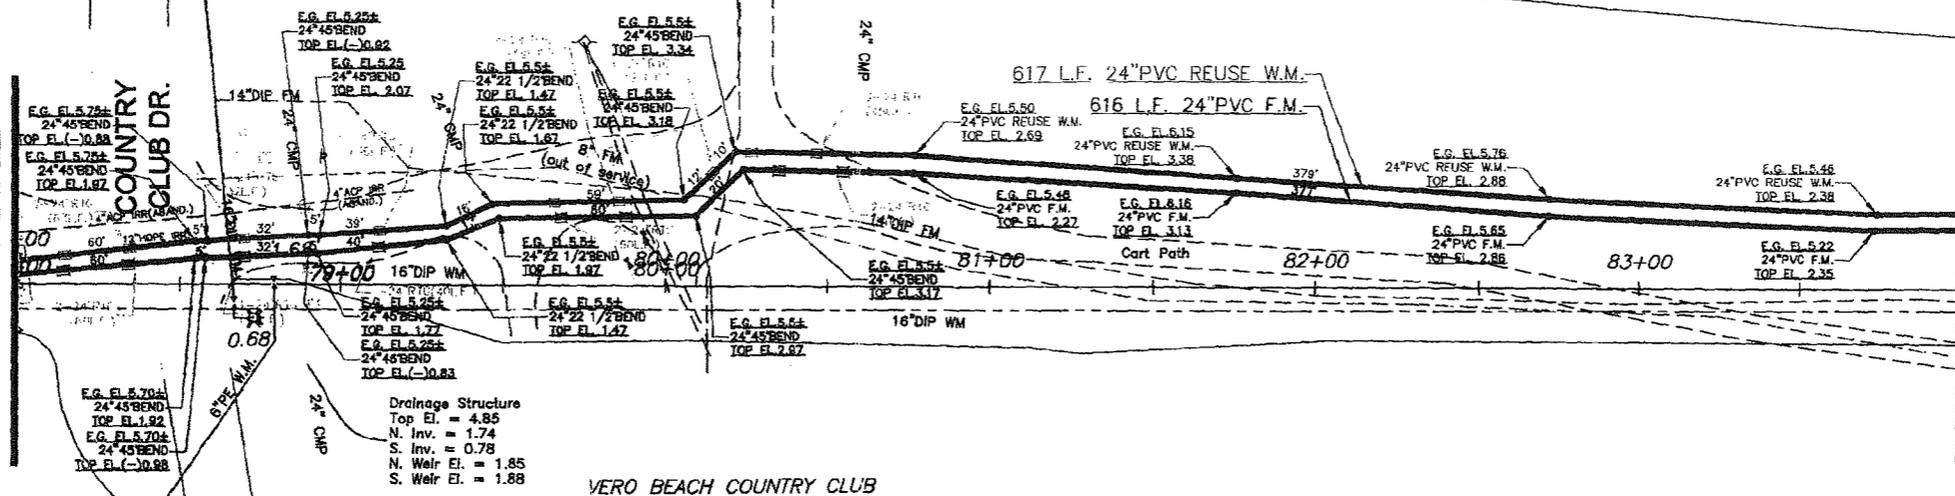


COUNTRY CLUB DR.

VERO BEACH COUNTRY CLUB

Drainage Structure
 Top El. = 4.85
 N. Inv. = 1.74
 S. Inv. = 0.78
 N. Weir El. = 1.85
 S. Weir El. = 1.88

SCALE: 1" = 20'

| | |
|----------------|----------|
| BENCHMARK | |
| PROFILE SCALES | |
| HORIZONTAL | 1" = 20' |
| VERTICAL | 1" = 2' |

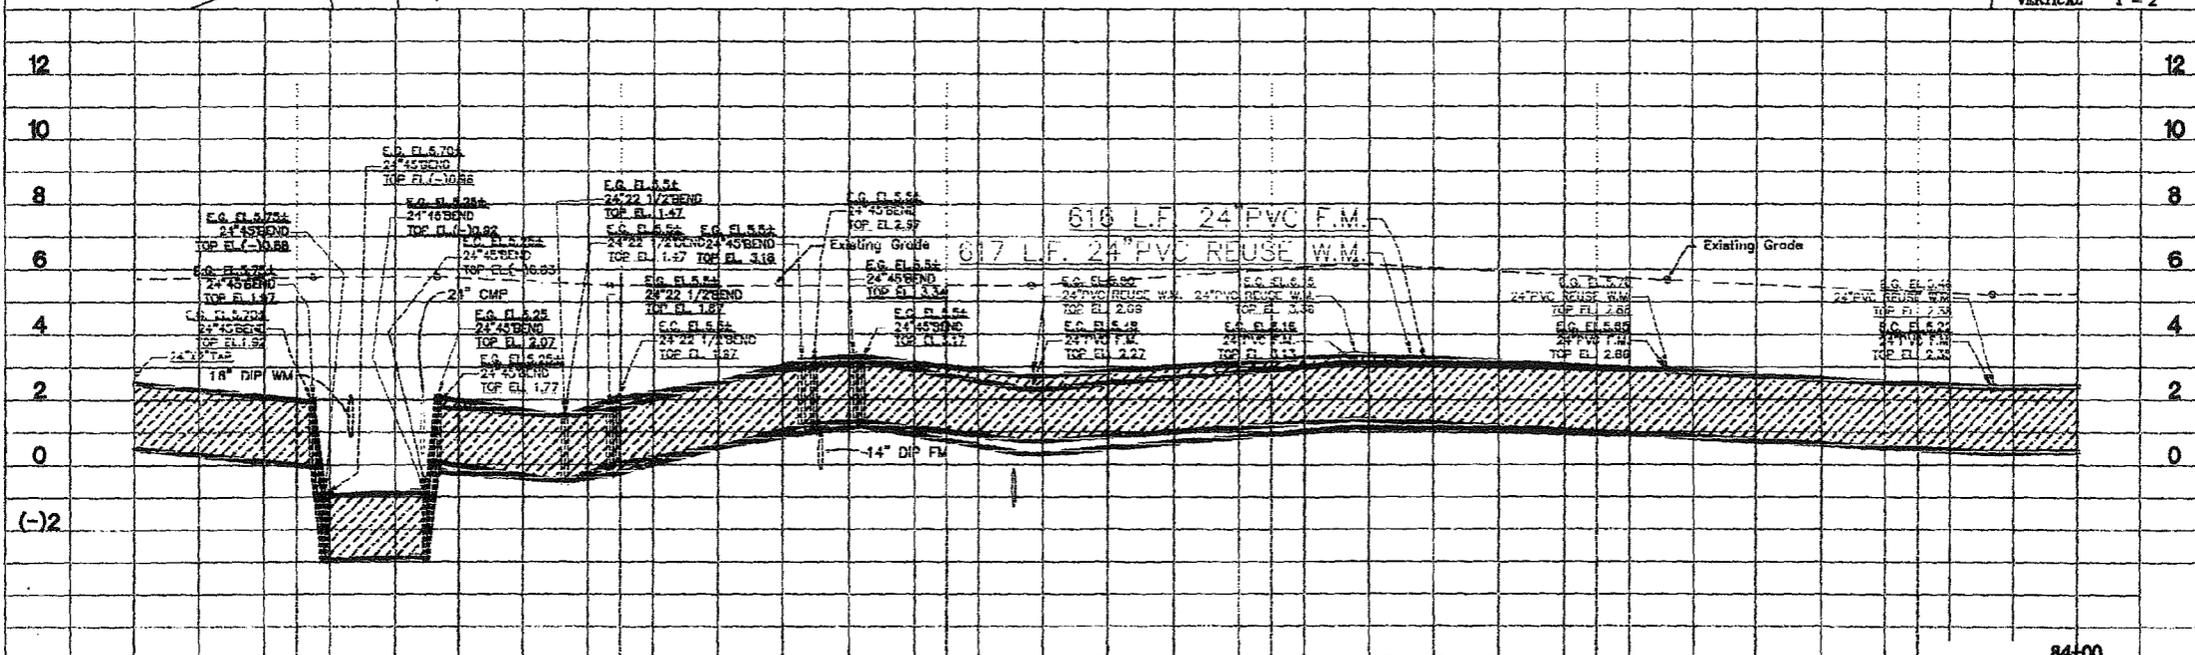

| | | | | | | |
|---------------------------------------|-------|-------------|---------------|---|-------|----------------------------|
| 78+00 | 79+00 | 80+00 | 81+00 | 82+00 | 83+00 | 84+00 |
| A AS-BUILT INFO, FIELD NOTES & SURVEY | | R.L.B. | T.A.Y. | FORCE MAIN FROM C.O.V.B. W.W.T.P. TO W.T.P. | | CITY OF VERO BEACH |
| REV. NO. | | DESCRIPTION | AUTHORIZED BY | DRAWN BY | DATE | WATER AND SEWER DEPARTMENT |

PLAN & PROFILE - I.R.F.W.D. MAIN CANAL R.O.W. STA. 78+00 - 84+00
 ROBERT J. BOLTON, P.E. FL. # 45469 DATE: 12/21/2010 CITY PROJECT # 100000004


MATCH LINE

MATCH LINE

Canal Dam Wall


I.R.F.W.C.D. MAIN CANAL

SCALE 1" = 20'

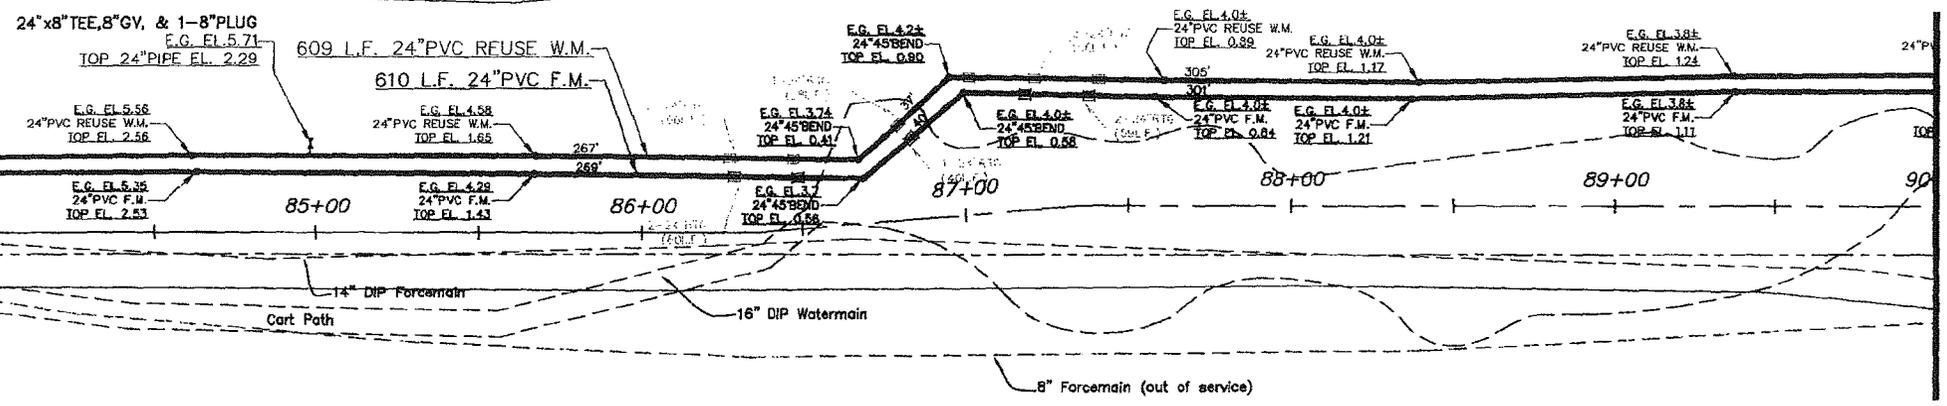

VERO BEACH COUNTRY CLUB

| | |
|----------------|----------|
| BENCHMARK | |
| PROFILE SCALES | |
| HORIZONTAL | 1" = 20' |
| VERTICAL | 1" = 2' |

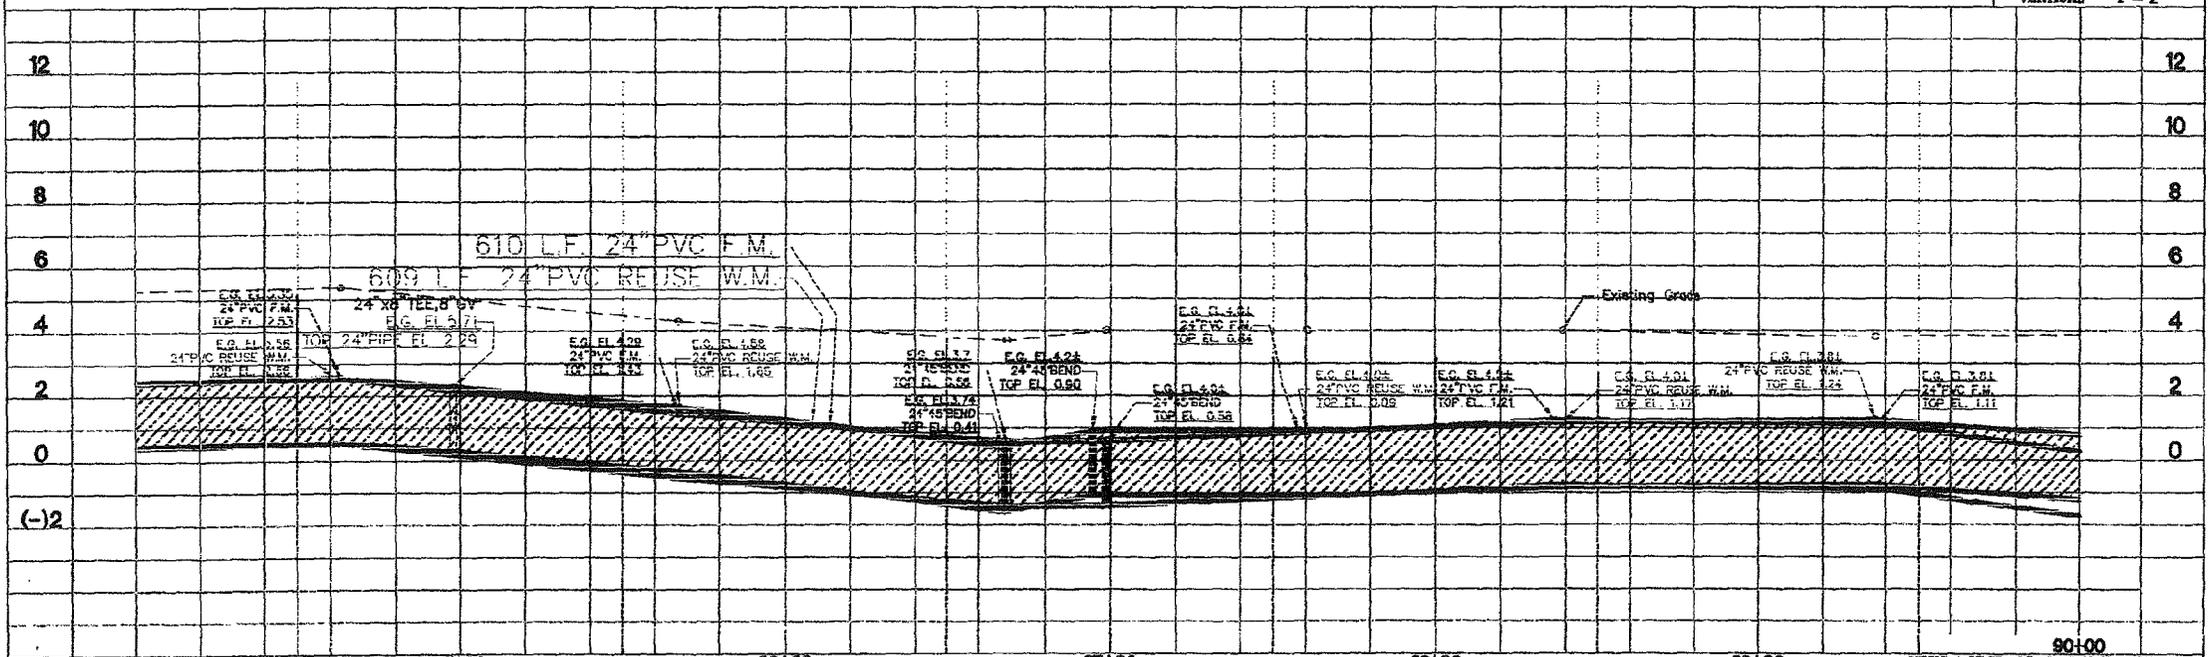


| | | | | | | |
|---|-------------|-------------|---|-------|-----------|--------------|
| 84+00 | 85+00 | 86+00 | 87+00 | 88+00 | 89+00 | 90+00 |
| FORCE MAIN FROM C.Q.V.B. W.W.T.P. TO W.T.P. | | | CITY OF VERO BEACH WATER AND SEWER DEPARTMENT | | | |
| AS-BUILT INFO, FIELD NOTES & SURVEY | | | PLAN & PROFILE - I.R.F.W.D. MAIN CANAL R.O.W. | | | |
| REV. NO. | DESCRIPTION | AUTHRZD. BY | T.A.Y. | DATE | LAY. DATE | NO. WS 07014 |

ROBERT J. BOLTON, P.E. FL # 49425
 DATE: 12/21/2010
 SHEET 28 OF 30

MATCH LINE


MATCH LINE

SCALE: T = 20'

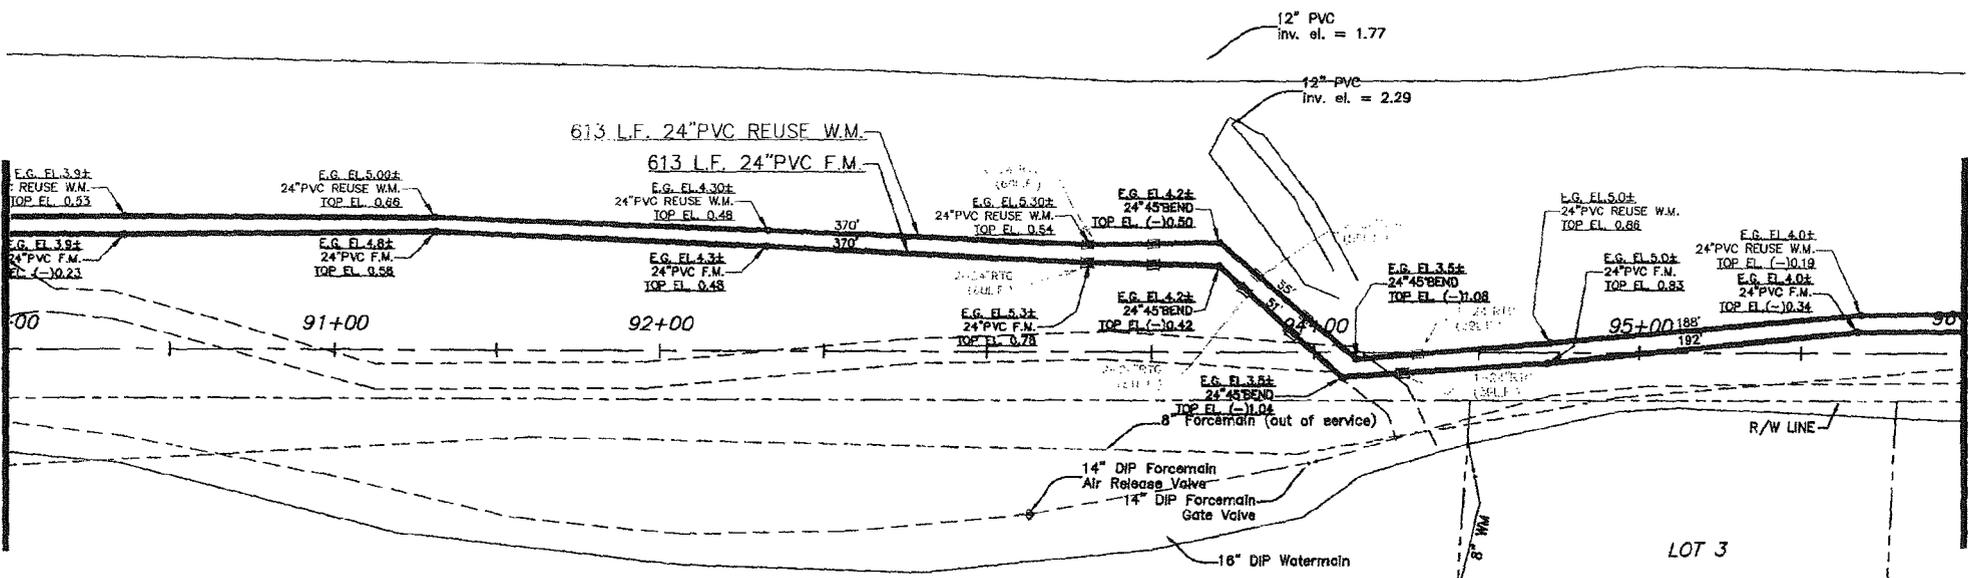

BENCHMARK

PROFILE SCALES
 HORIZONTAL 1" = 20'
 VERTICAL 1" = 2'

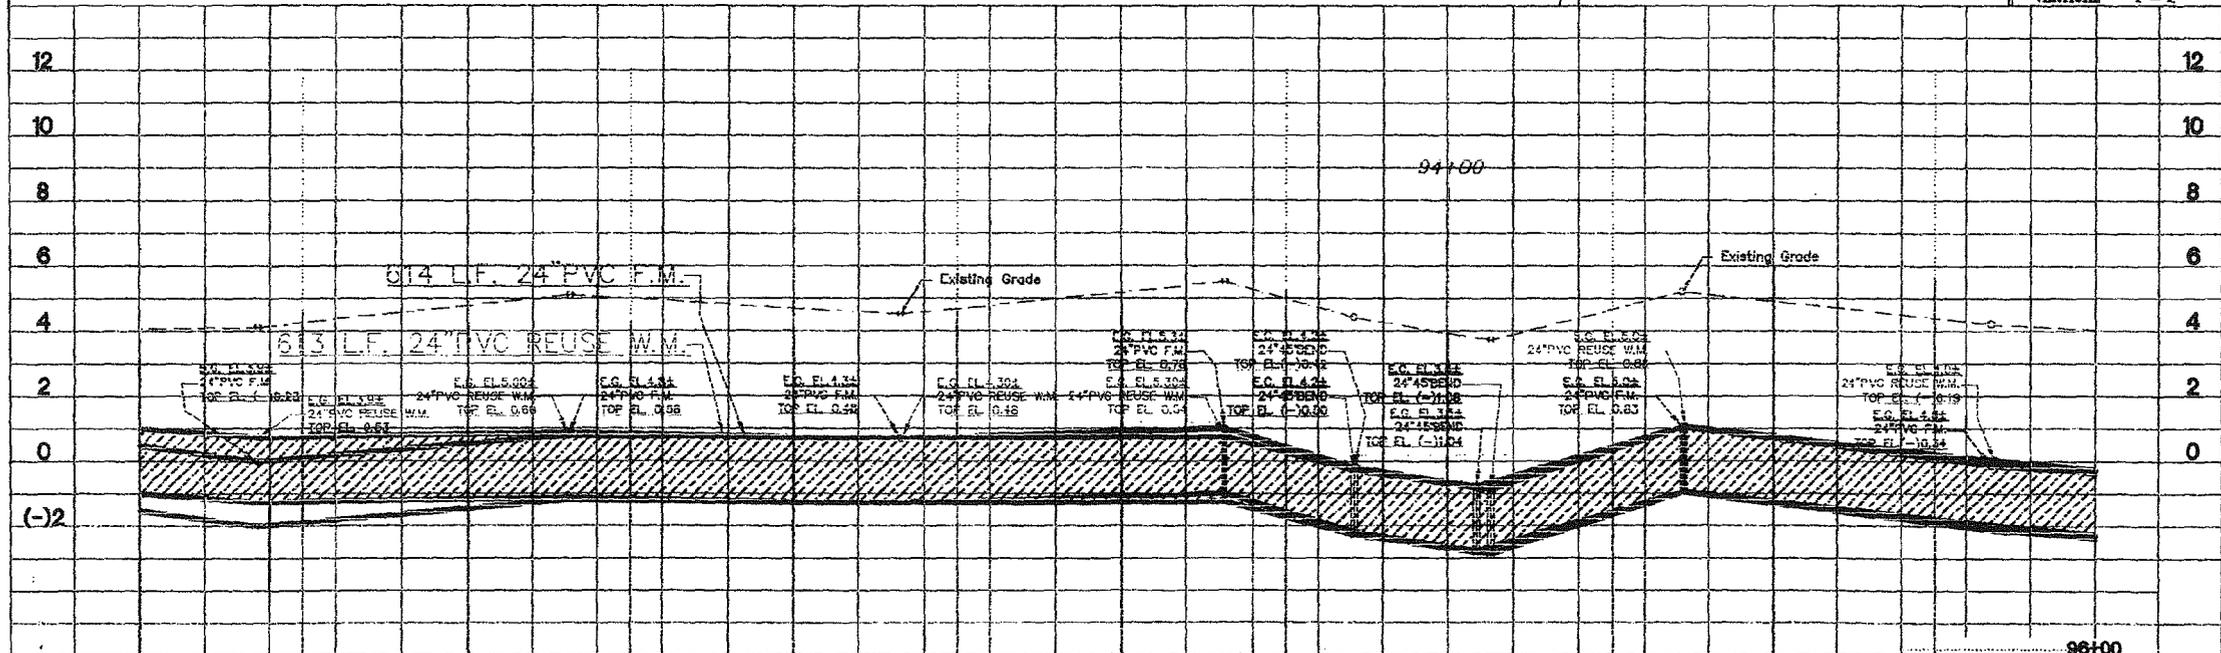

| | | | | | | |
|---------------------------------------|-------|-----------|----------|---|-------|-----------------------------------|
| 90+00 | 91+00 | 92+00 | 93+00 | 94+00 | 95+00 | 96+00 |
| A AS-BUILT INFO, FIELD NOTES & SURVEY | | R.L.B. | T.A.Y. | B/13/2010 | | DATE |
| DESCRIPTION | | AUTHZD BY | DRAWN BY | FORCE MAIN FROM C.O.V.B. W.W.T.P. TO W.T.P. | | CITY OF VERO BEACH |
| | | | | AS-BUILT DRAWING | | WATER AND SEWER DEPARTMENT |
| | | | | PLAN & PROFILE - I.R.F.W.D. MAIN CANAL R.O.V. | | ROBERT J. NELSON, P.E. FL # 49489 |
| | | | | STA. 90+00 - 96+00 | | DATE 07/21/2010 |
| | | | | | | 12/1/2010 |


MATCH LINE

I.R.F.W.C.D. MAIN CANAL

517 L.F. 24" PVC REUSE W.M.
518 L.F. 24" PVC F.M.

MATCH LINE
SHEET 16 OF 30


SCALE 1" = 20'

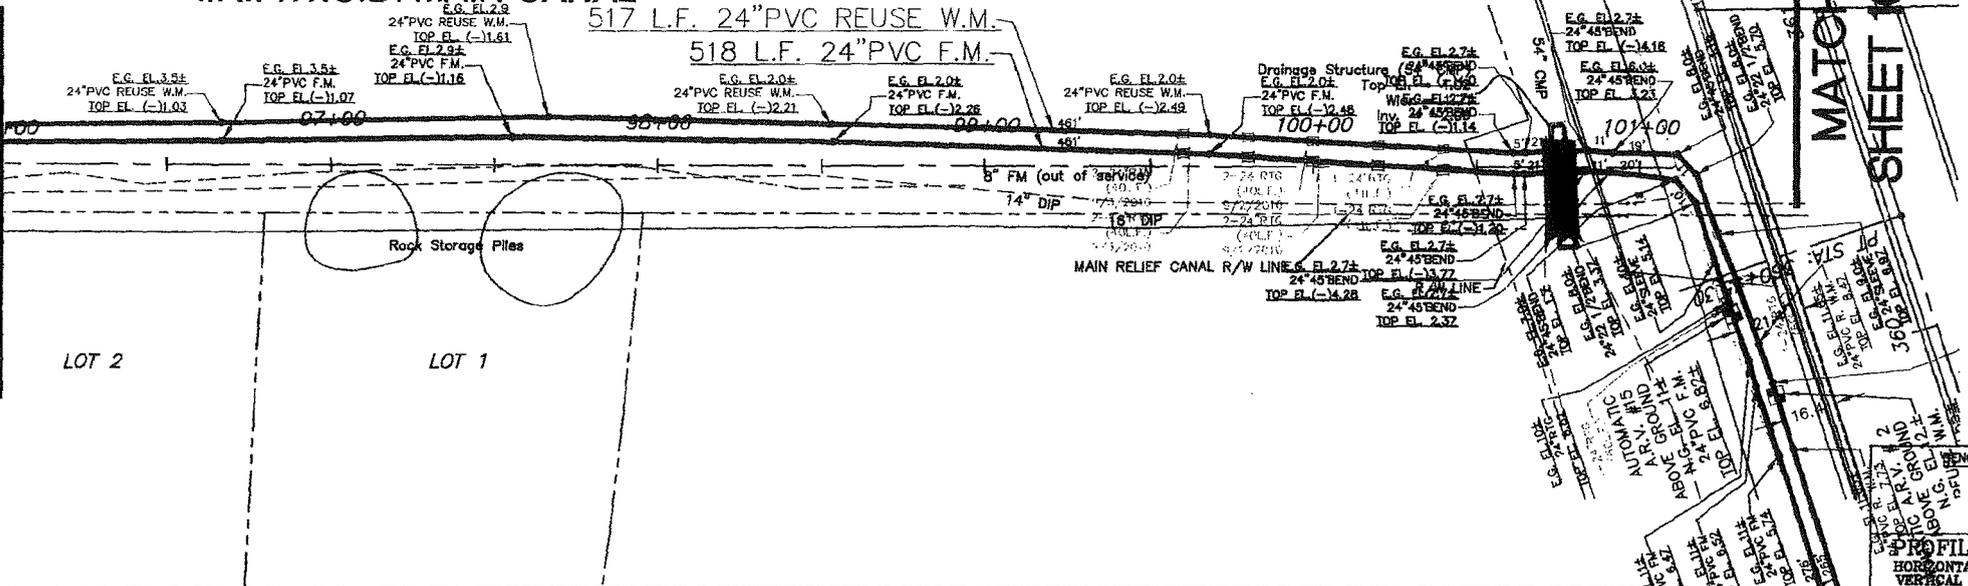

LOT 2

LOT 1

PROFILE SCALES
HORIZONTAL 1" = 20'
VERTICAL 1" = 2'

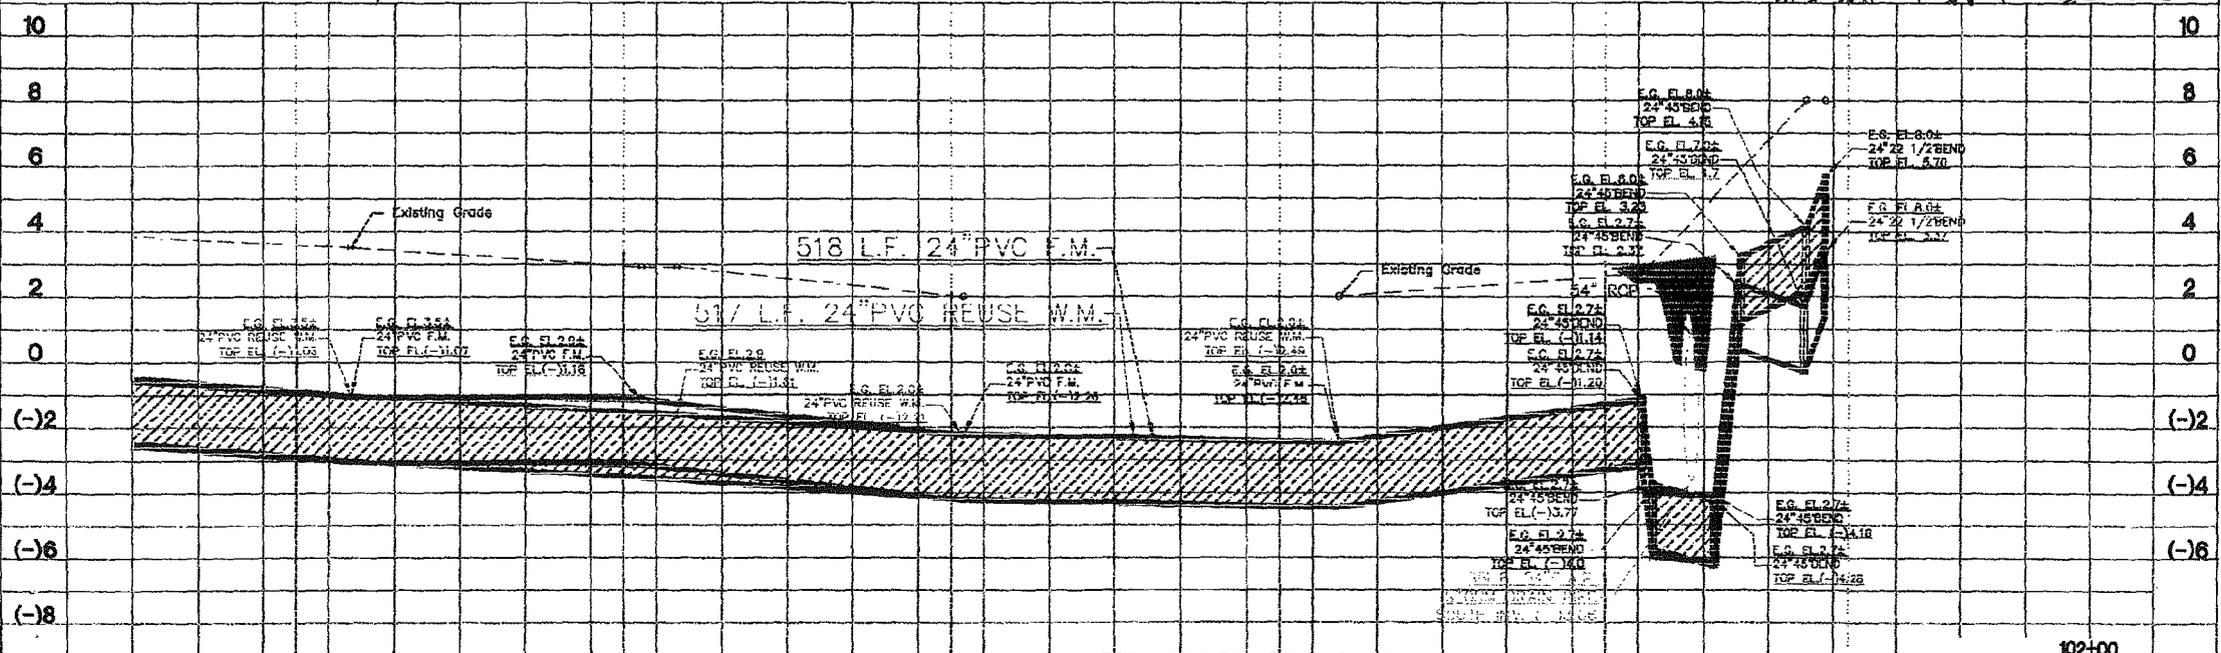

| | | | | | | |
|---|-------|-------|-------|--------|--------|--------|
| 96+00 | 97+00 | 98+00 | 99+00 | 100+00 | 101+00 | 102+00 |
| FORCE MAIN FROM C.O.V.B. W.W.T.P. TO W.T.P. CITY OF VERO BEACH WATER AND SEWER DEPARTMENT PLAN & PROFILE - I.R.F.W.C.D. MAIN CANAL R.O. STA. 96+00 - 102+00 | | | | | | |

| | | | | | | |
|----------|-------------------------------------|------------|----------|-----------|------|------|
| REV. NO. | DESCRIPTION | AUTHZD. BY | DRAWN BY | DATE | DATE | DATE |
| A | AS-BUILT INFO, FIELD NOTES & SURVEY | R.J.B. | T.A.Y. | 9/13/2010 | | |

ROBERT J. SULTON, P.E. FL # 49489
DATE: 9/21/2010
CITY PROJECT